


T.11S.R.5W.W.M.

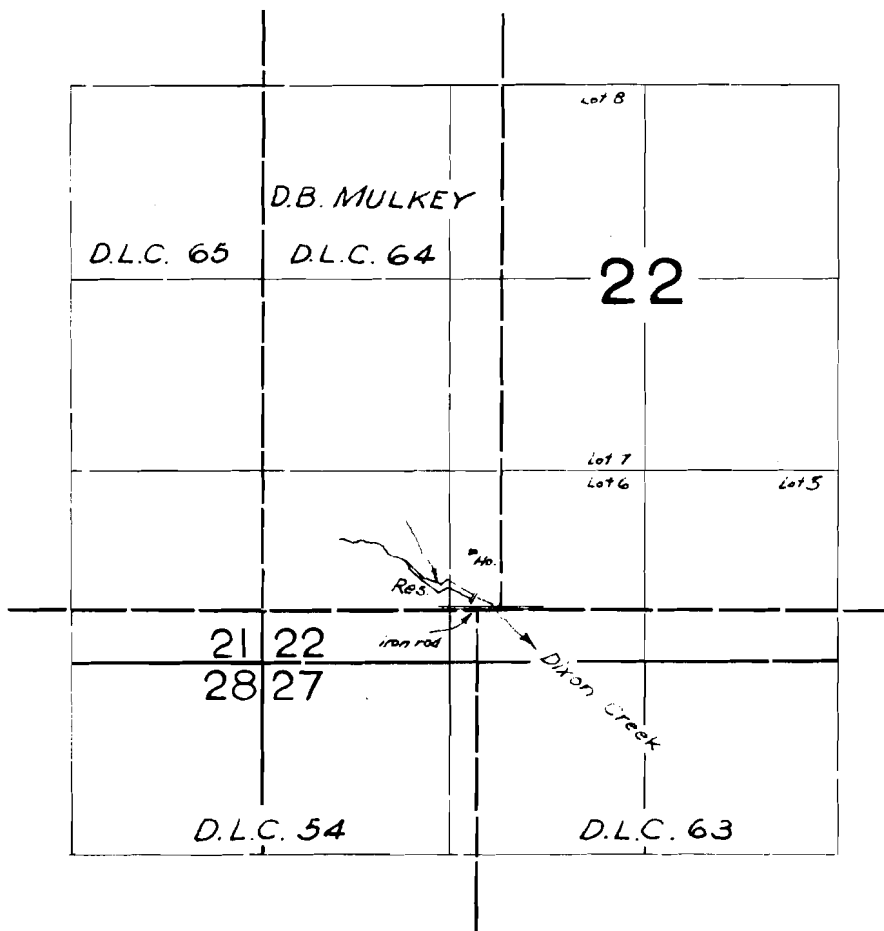

FINAL PROOF SURVEY UNDER

R-31151 *R-1951*
Application No. *31152* Permit No. *24550*
IN NAME OF

Surveyed *9 March* 1959, by *R.H. Jackson*