


T. 3S. R. 1E. W.M.

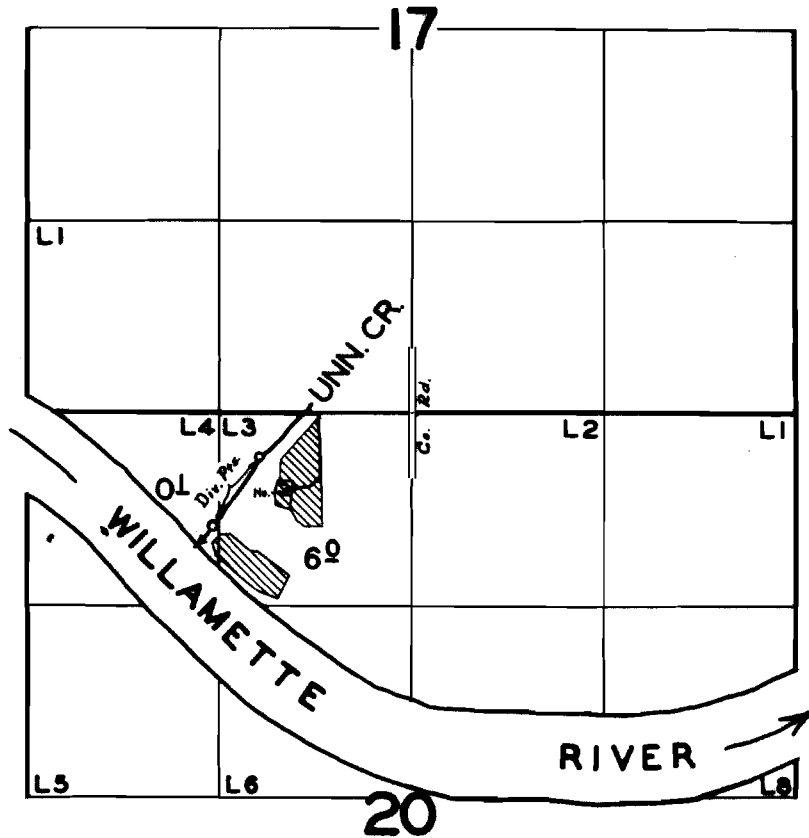

**FINAL PROOF SURVEY**  
UNDER

Application No. 18403 Permit No. 14040  
IN NAME OF

**LLOYD M. SIMONS**

Surveyed JUN. 12 1959, by M. BISH