


# T. 6S. R. 1E. W.M.

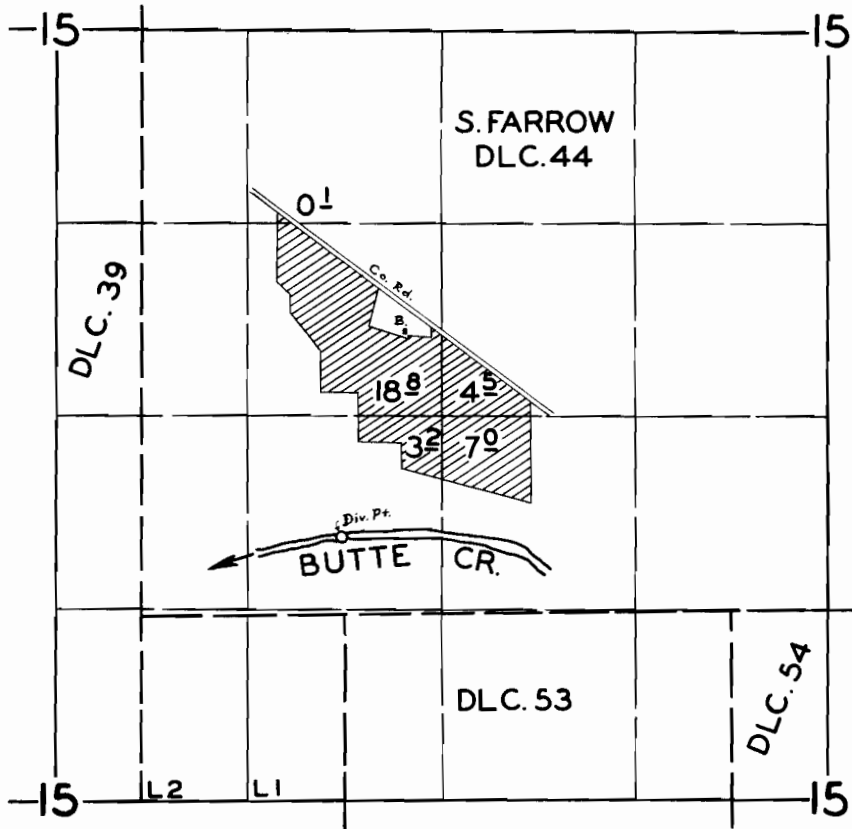

## FINAL PROOF SURVEY UNDER

Application No. 28314 Permit No. 22262  
IN NAME OF

**RICHARD D. HARRIS**

Surveyed APR. 28 1959, by M. BISH