


T. 4S. R. 3E. W.M.

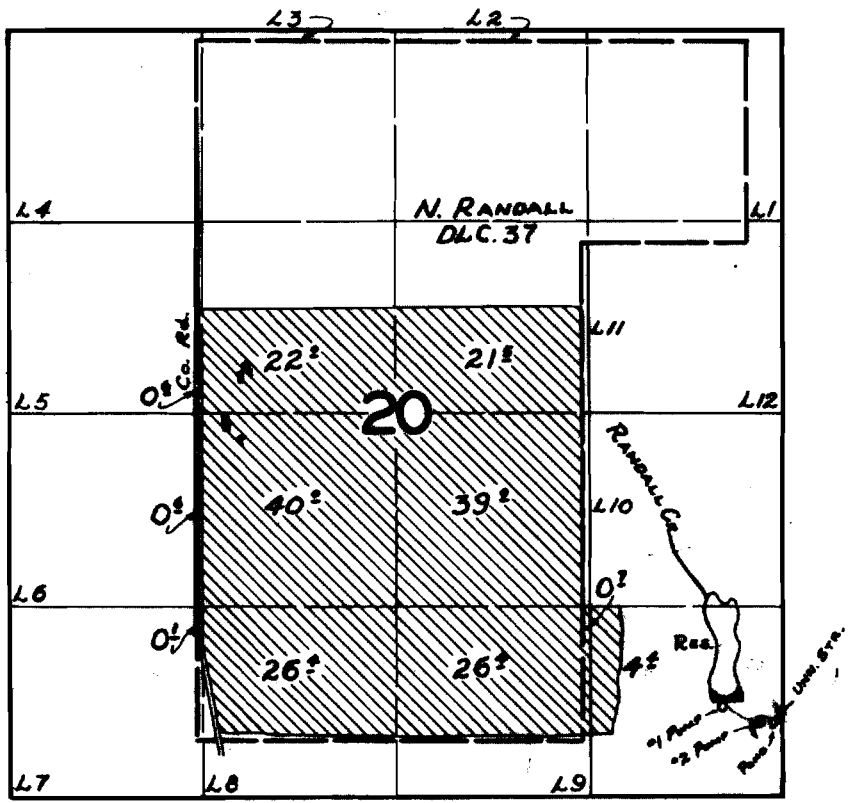

FINAL PROOF SURVEY

UNDER
R-26709 R-1512
Application No. 26710 Permit No. 22417
IN NAME OF
BEN ELMER FARMS
Surveyed SEPT. 11 19 59, by R. H. JACKSON