


T. 4S. R. 3E. W.M.

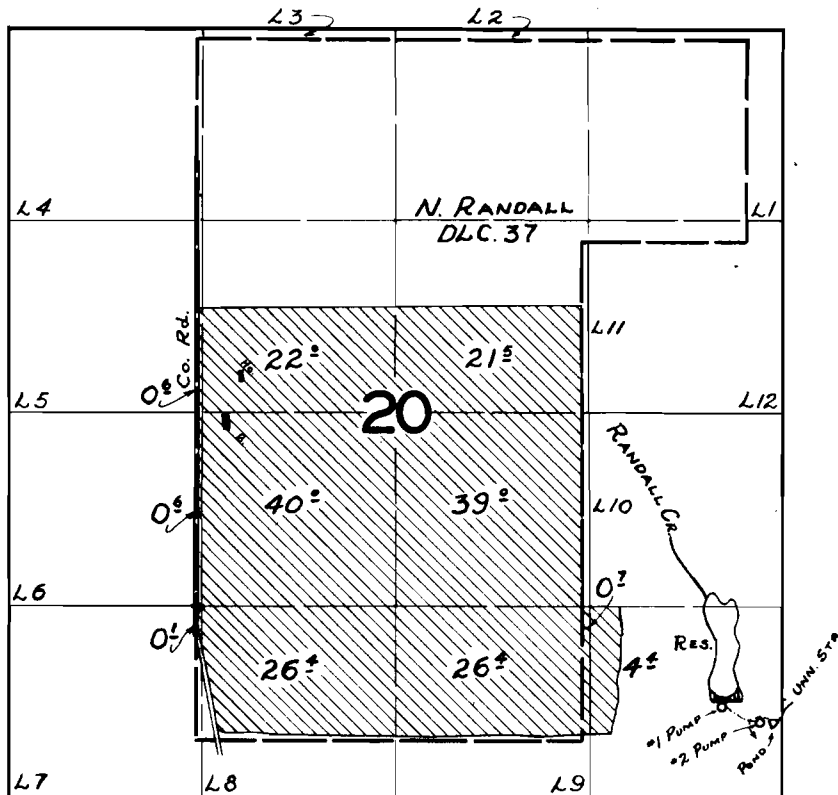

FINAL SURVEY

R-26709
26710

R-1512
22417

BEN ELMER FARMS

SEPT. 11 1959

R. H. JACKSON