


T. 4S. R. 2E. W.M.

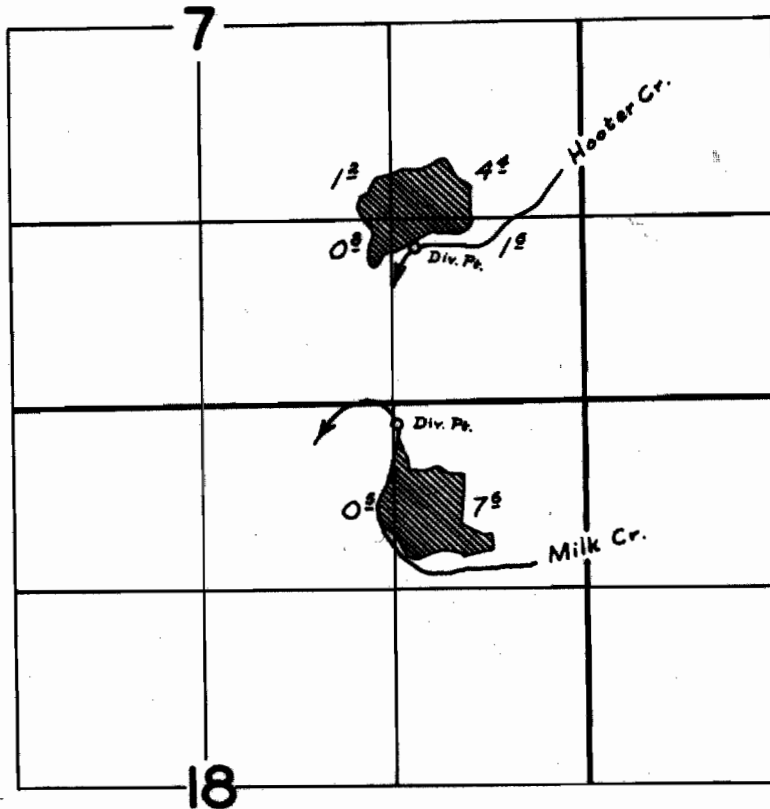

FINAL PROOF SURVEY

UNDER

Application No. 29107 Permit No. 23483

IN NAME OF

Henry & Pearl Freeman

Surveyed July 9, 1959, by R.H. Jackson