


T. 5S. R. 2E. W.M.

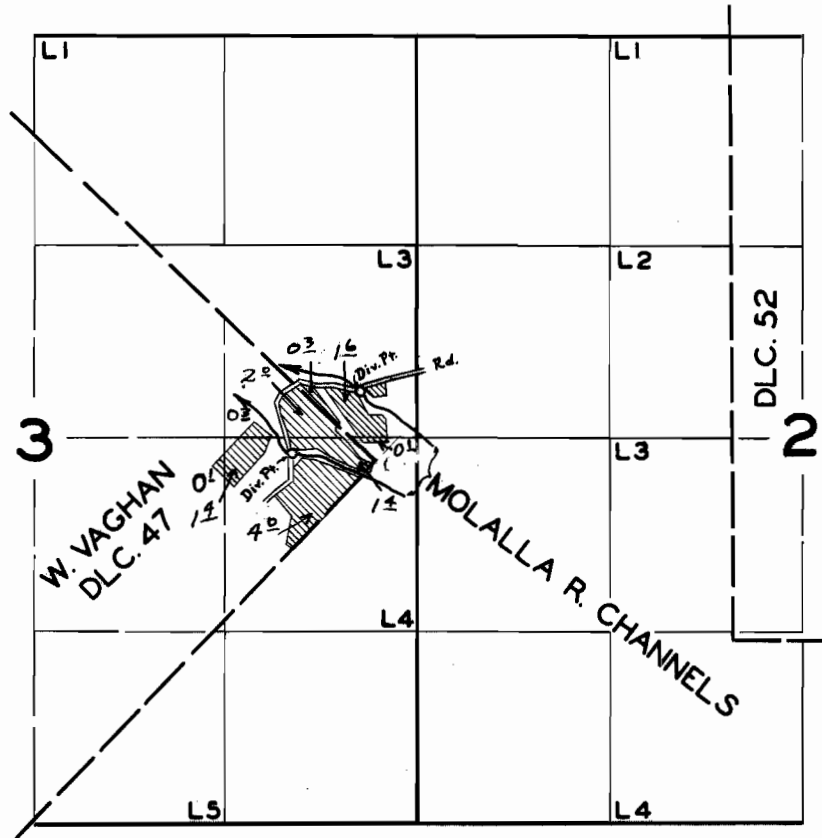

FINAL PROOF SURVEY UNDER

Application No. 29559 Permit No. 23493
IN NAME OF

DALE W. & LUCY HOLMES

Surveyed APR. 27, 1959, by M. BISH