


T. 2S. R. 1E. W.M.

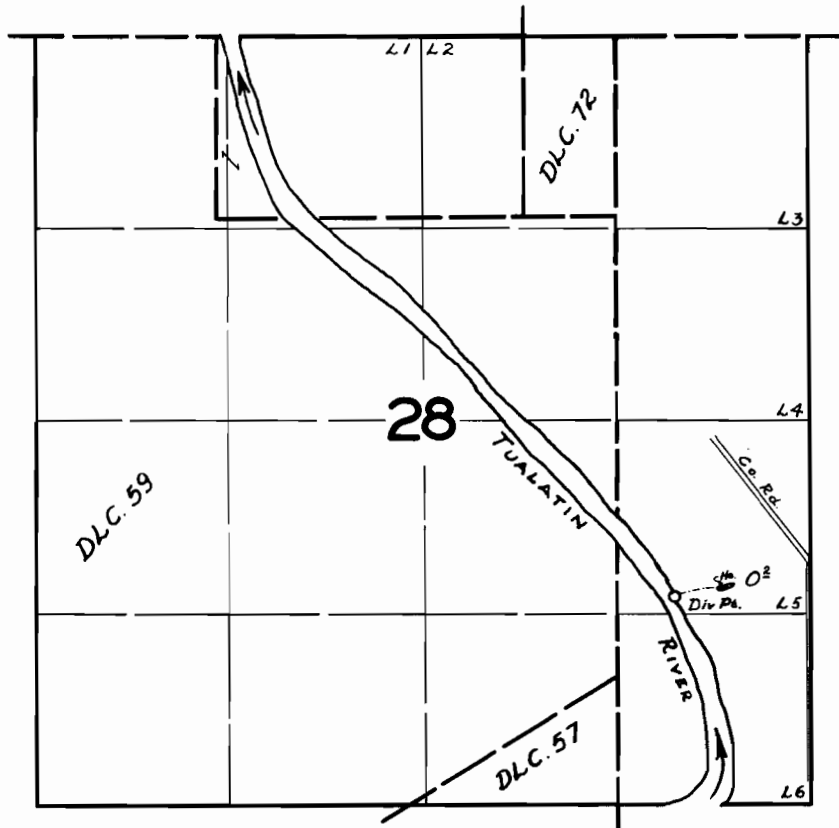

FINAL PROOF SURVEY

UNDER

Application No. 29997 Permit No. 23627

IN NAME OF

GILBERT W. WILCOX

Surveyed JULY 3 1959 by R. H. JACKSON