


T. 5S. R. 2E. W.M.

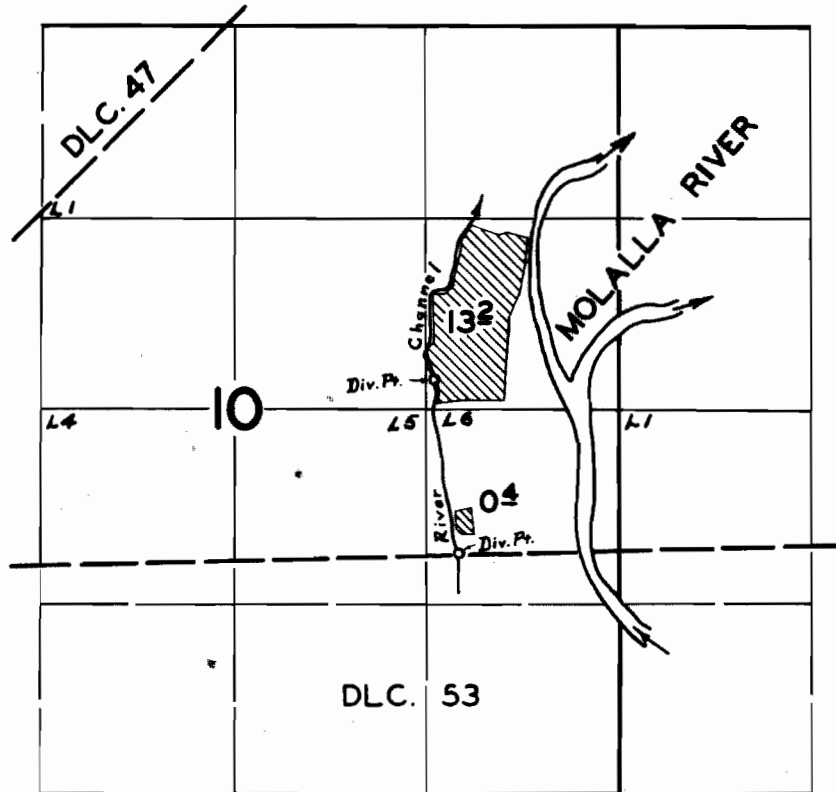

FINAL PROOF SURVEY
UNDER

Application No. 27866 Permit No. 23663
IN NAME OF

JAMES J. DERBY

Surveyed APR. 29 1959, by M. BISH