


T. 5S. R. 2E. W.M.

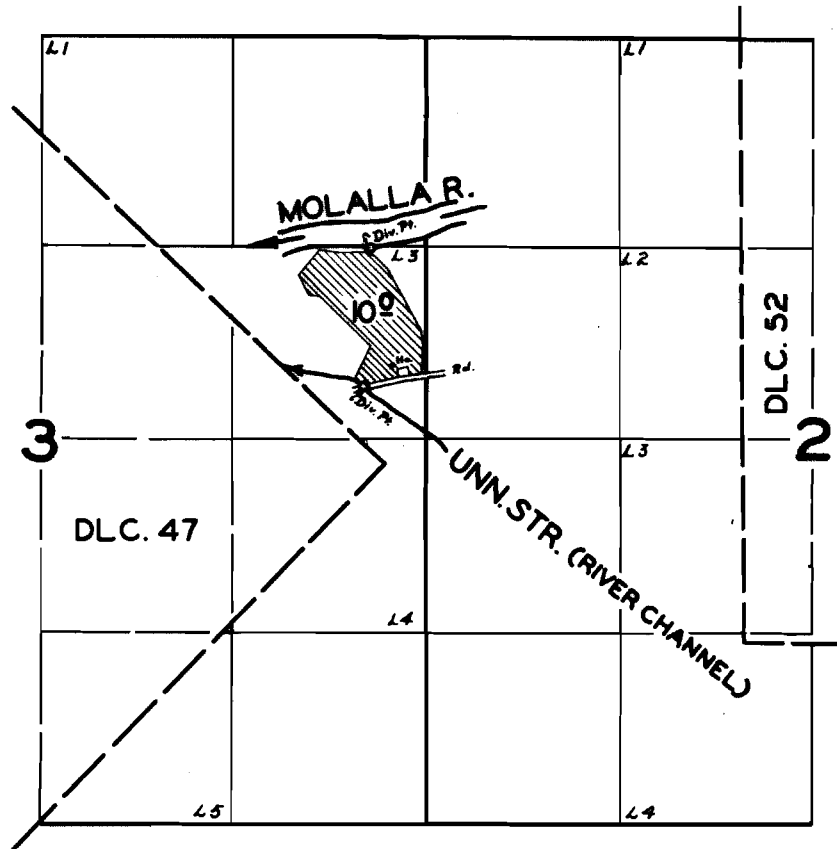

**FINAL PROOF SURVEY**  
UNDER

Application No. 30267 Permit No. 23722  
IN NAME OF

CHARLES F. BUHMAN

Surveyed APR. 28 1959, by M. BISH