


T. 3S. R. 2E. W.M.

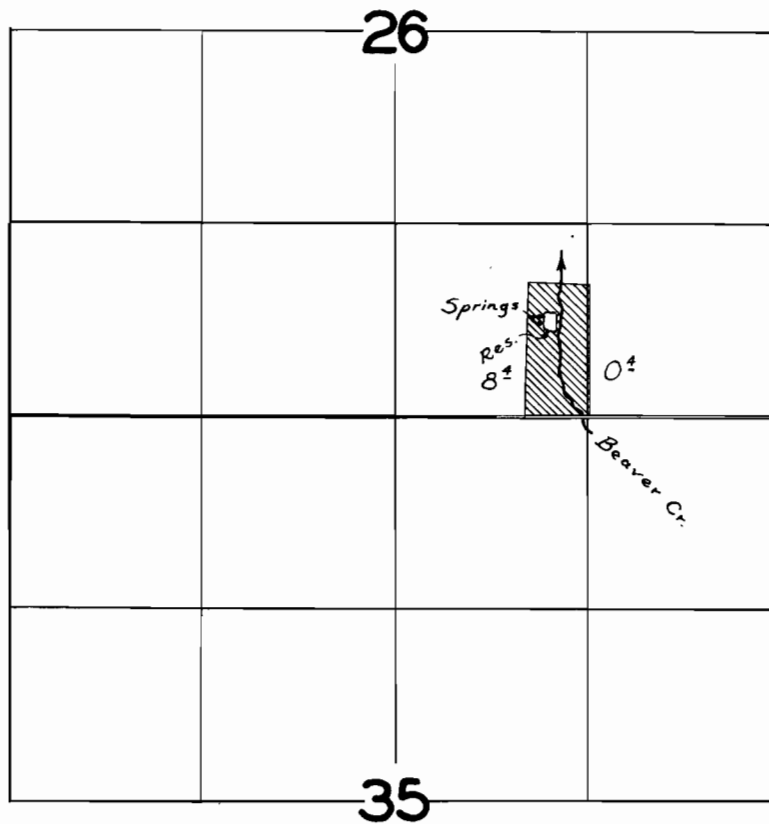

FINAL PROOF SURVEY

RECORDED
R-31170 R-1955
31171 24565

NAME OF

George Hollmann

Surveyed July 10 1959 by R. H. Jackson