


T. 3S. R. 2E. W.M.

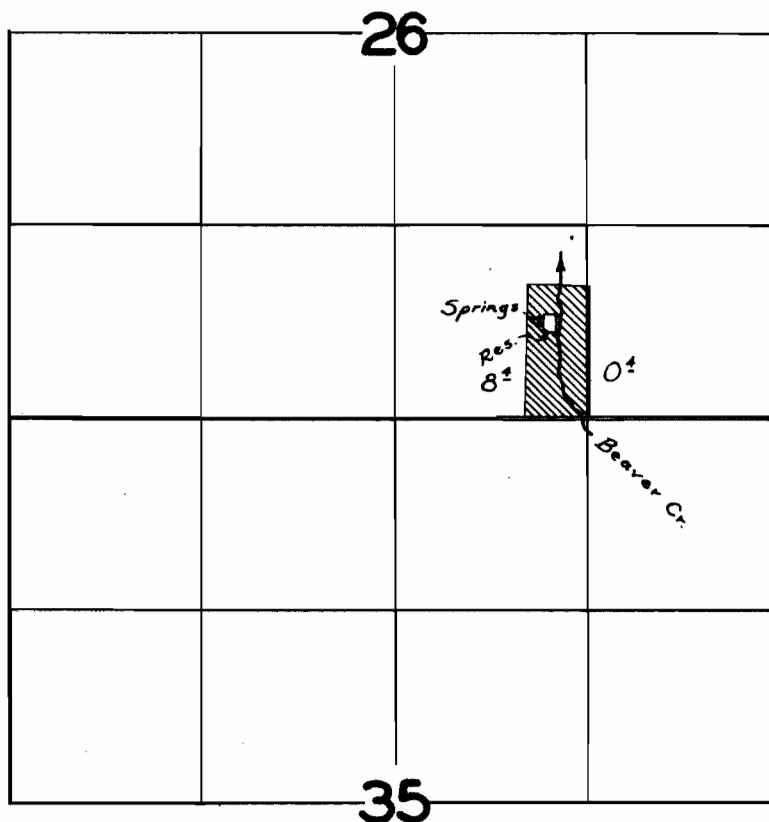

FINAL PROOF SURVEY

UNDER

R-31170

R-1955

Application No. 31171 Permit No. 24565

IN NAME OF

George Hollmann

Surveyed July 10 1959, by R. H. Jackson