


T. 3S. R. 1E. W.M.

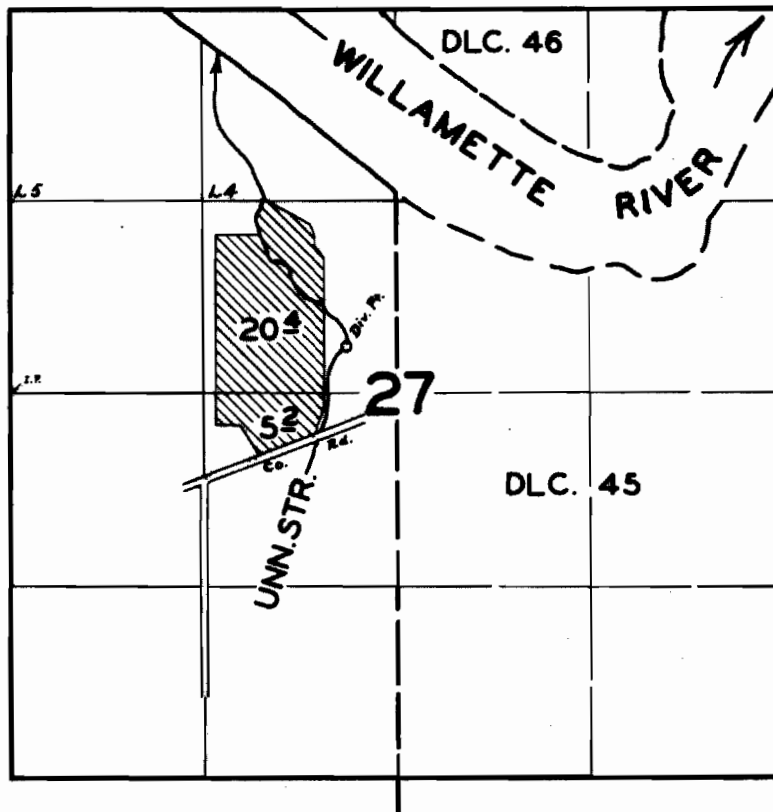

FINAL PROOF SURVEY
UNDER

Application No. 31047 Permit No. 24596
IN NAME OF

GORDON R. ANDRUS

Surveyed JUN. 12, 1959, by M. BISH