


T. 2S. R. 1E. W.M.

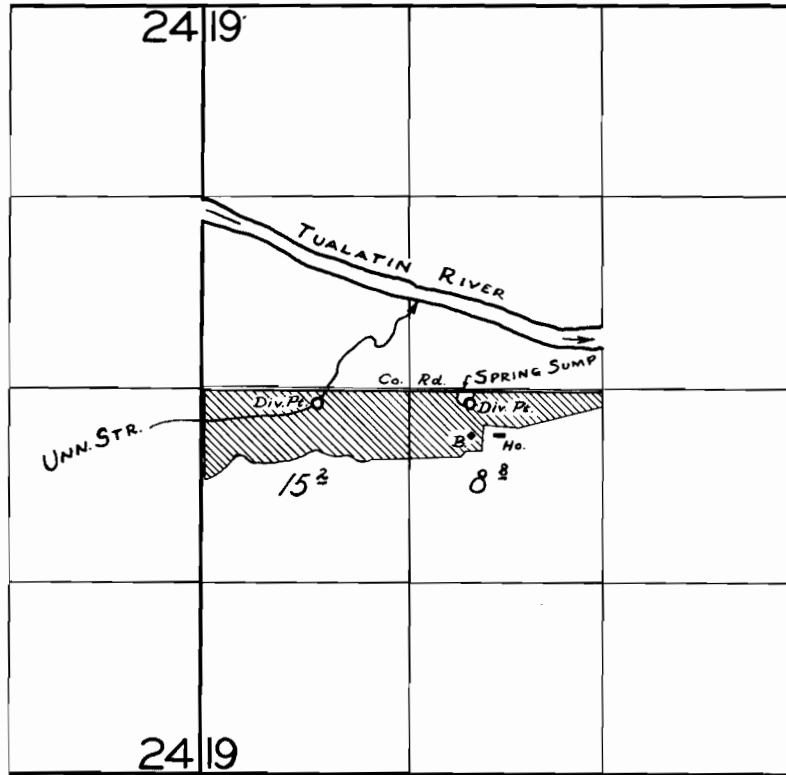

FINAL PROOF SURVEY

UNDERS

Application No. 31016 and Plat No. 24677

SECTION 15

ALTON W. & EDITH E. EMMONS

Surveyed JULY 3 1959 by R.H. JACKSON