


T. 4S. R. 3E. W.M.

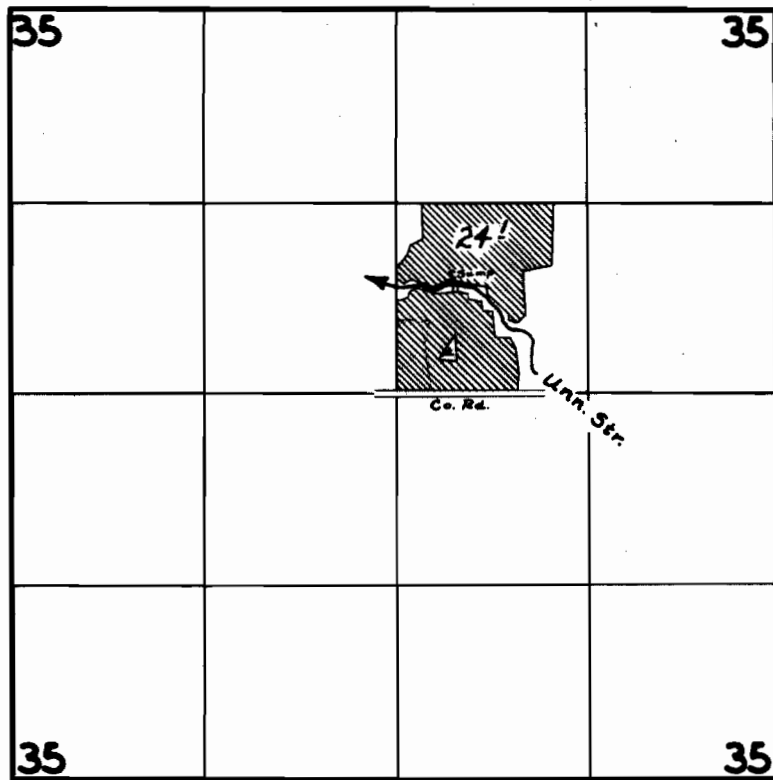

**FINAL PROOF SURVEY**  
UNDER

Application No. 32224 Permit No. 25463  
IN NAME OF

Stanley J. Drummond

Surveyed Sept. 11, 1959, by R.H. Jackson