


T. 6N. R. 4W. W.M.

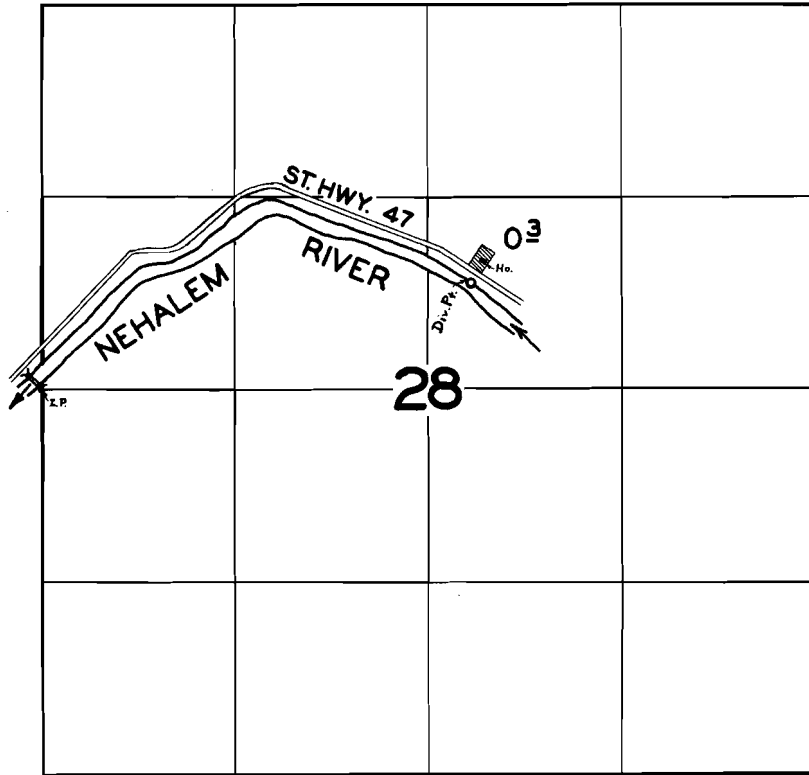

FINAL PROOF SURVEY
UNDER

Application No. 27622 Permit No. 21758
IN NAME OF

CLYDE HENDERSON

Surveyed JULY 7 1959, by M. BISH