


T. 6N. R. 2W. W.M.

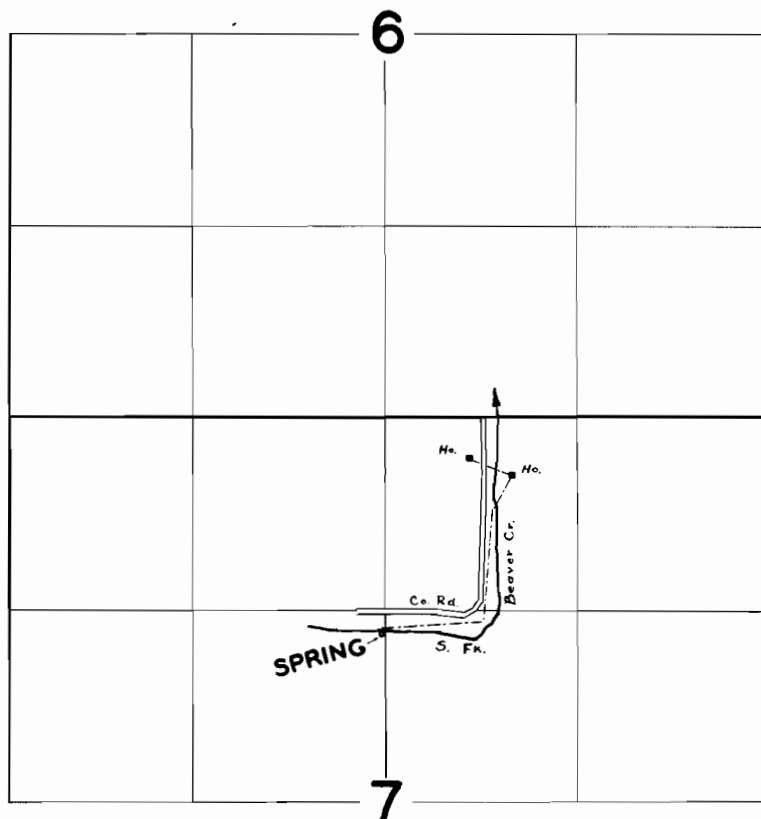

FINAL PROOF SURVEY
UNDER

Application No. 30223 Permit No. 23827
IN NAME OF

GUS LENTZ

Surveyed JULY 9 1959, by M. BISH