


T. 28S. R. 4W. W.M.

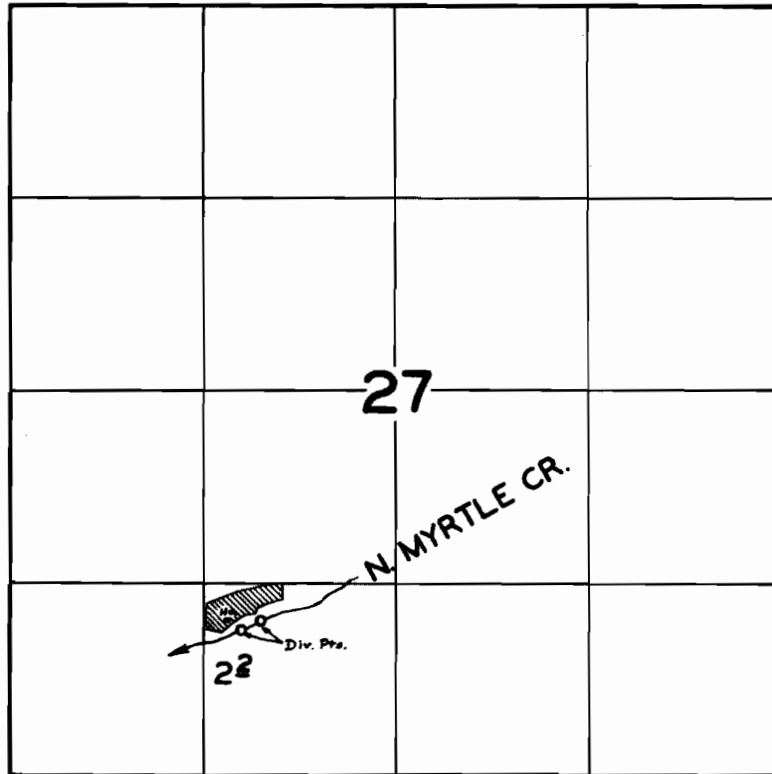

FINAL PROOF SURVEY
UNDER

Application No. 23852 Permit No. 18823
IN NAME OF

W.A. OGDEN

Surveyed JUN. 23 1959, by M. BISH