


T. 32S. R. 4&5W. W.M.

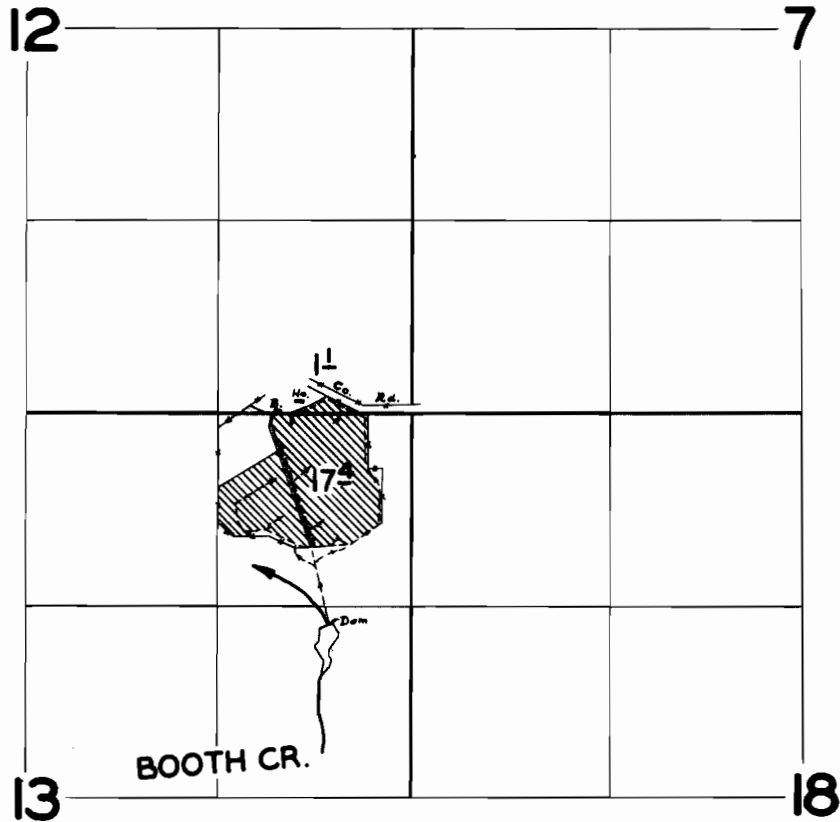

**FINAL PROOF SURVEY**  
UNDER

Application No. 28974 Permit No. 22725  
IN NAME OF

HARRISON L. SMITH

Surveyed JUN. 18 1959, by M. BISH