


T. 30S. R. 4W. W.M.

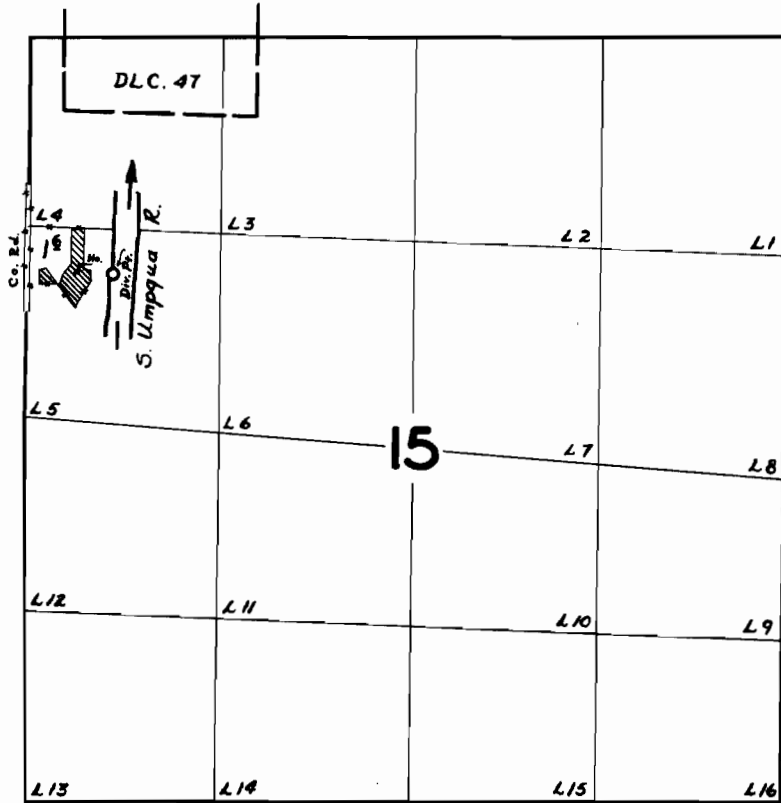

FINAL PROOF SURVEY
UNDER

Application No. 28644 Permit No. 22817
IN NAME OF

RAY F. CRAWFORD

Surveyed JUN. 20 1959, by M. BISH