


T. 28S. R. 6W. W.M.

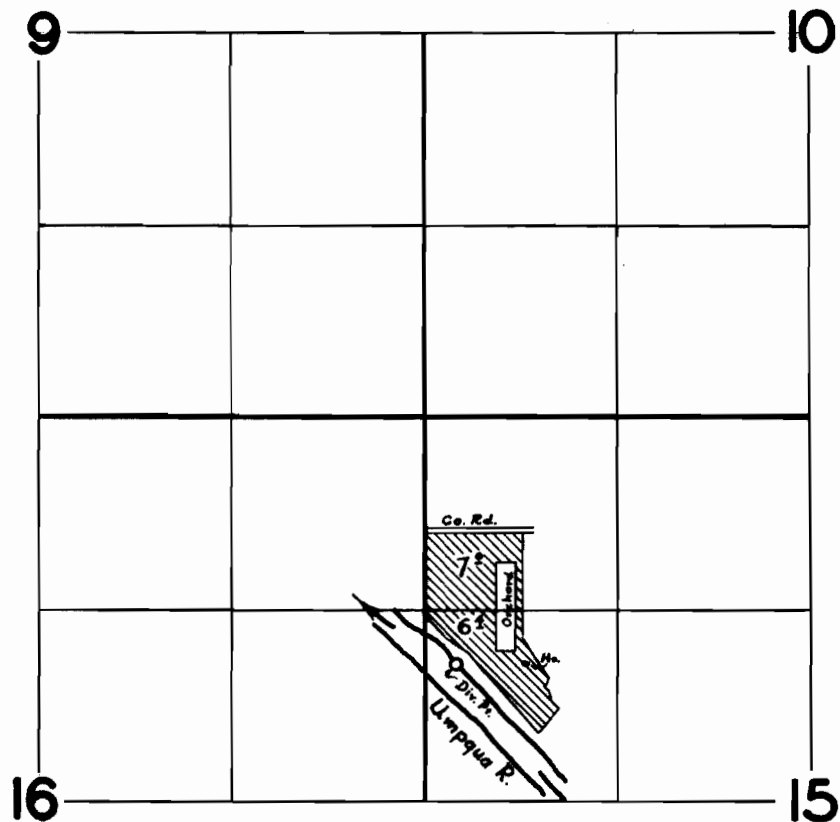

FINAL PROOF SURVEY
UNDER

Application No. 29773 Permit No. 23574
IN NAME OF

HENRY L. & MARIE F. LANDER

Surveyed JUN. 24 1959, by M. BISH