


T. 29S. R. 5W.W.M.

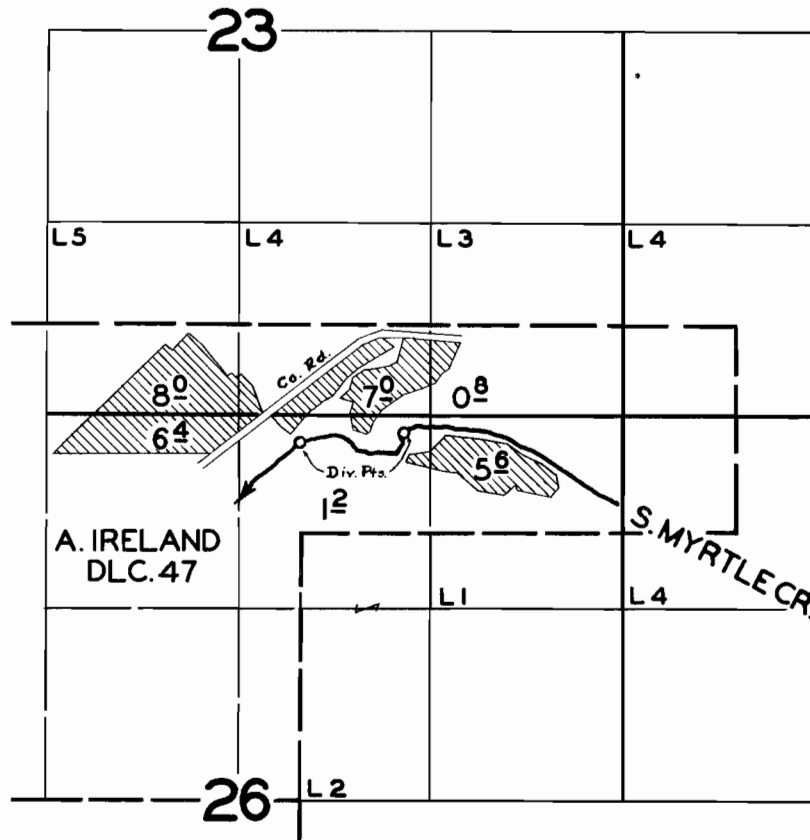

FINAL PROOF SURVEY  
UNDER

Application No. 29925 Permit No. 23581  
IN NAME OF

WALTER M. MEYER

Surveyed JUN. 22 1959, by M. BISH