


T. 30S. R. 5W. W.M.

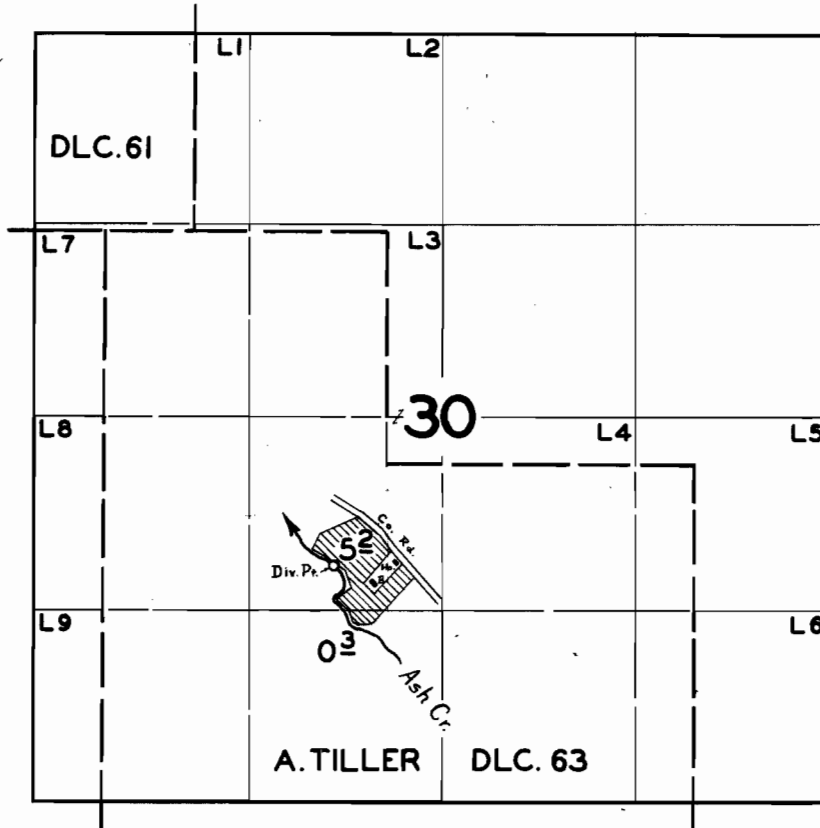

**FINAL PROOF SURVEY**  
UNDER

Application No. 31851 Permit No. 25111  
IN NAME OF

EVERETT M. SHELBY

Surveyed JUN. 22 1959 by M. BISH