


T. 30S. R. 6W. W.M.

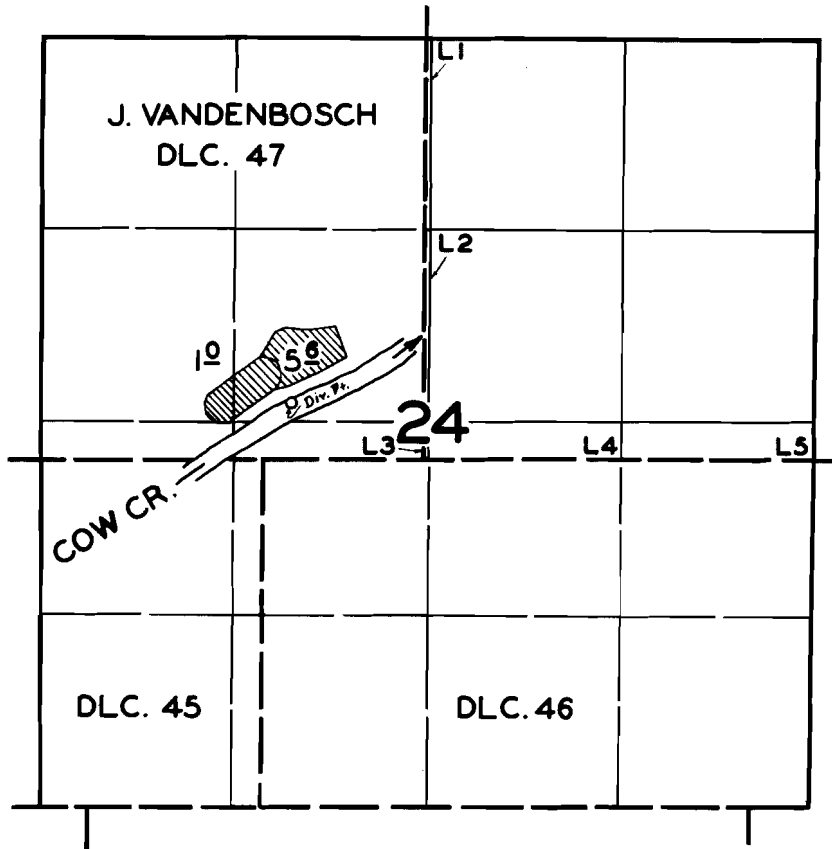

FINAL PROOF SURVEY
UNDER

Application No. 32481 Permit No. 25825
IN NAME OF

RIDDLE SCHOOL DISTRICT #70

Surveyed JUN. 20 1959 by M. BISH