


T. 13S. R. 31E. W.M.

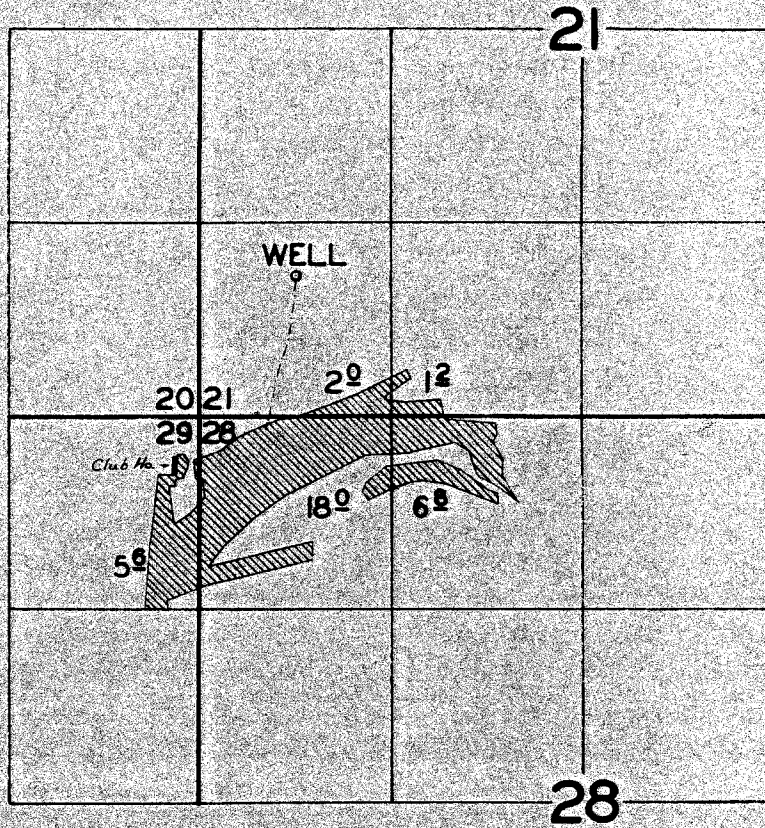

FINAL PROOF SURVEY

UNDER

Application No. G-635 Patent No. G-553

IN NAME OF

MT. VIEW COUNTRY CLUB

Surveyed AUG. 6 1959 by M. BISH