


T. 13S. R. 27E. W.M.

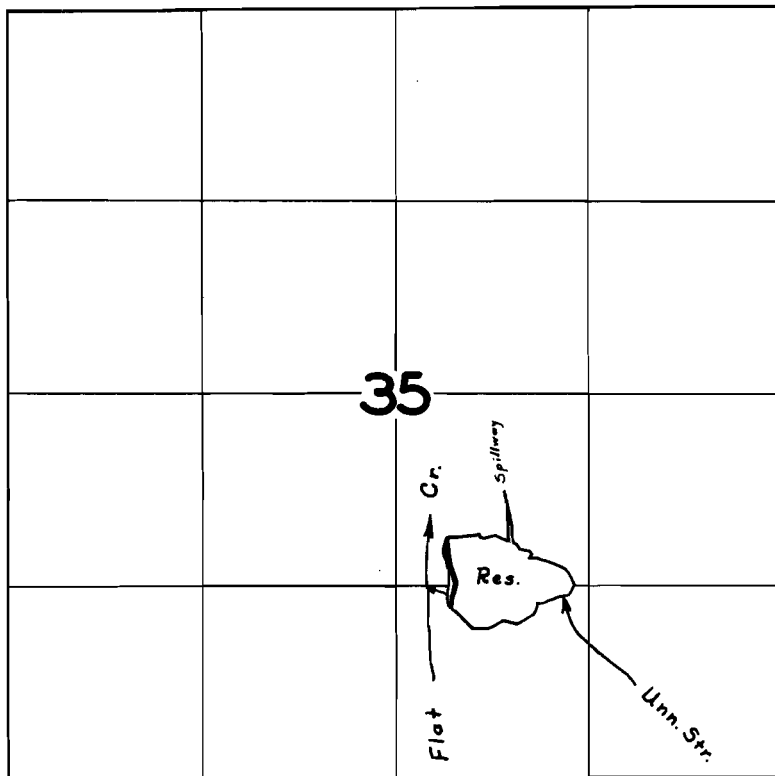

FINAL PROOF SURVEY

UNDER

R-20112

R-785

Application No. 20113

Permit No. 15634

IN NAME OF

PINE TREE LUMBER CO.

Surveyed AUG. 8 1959, by M. BISH