


T. 18S. R. 28E. W.M.

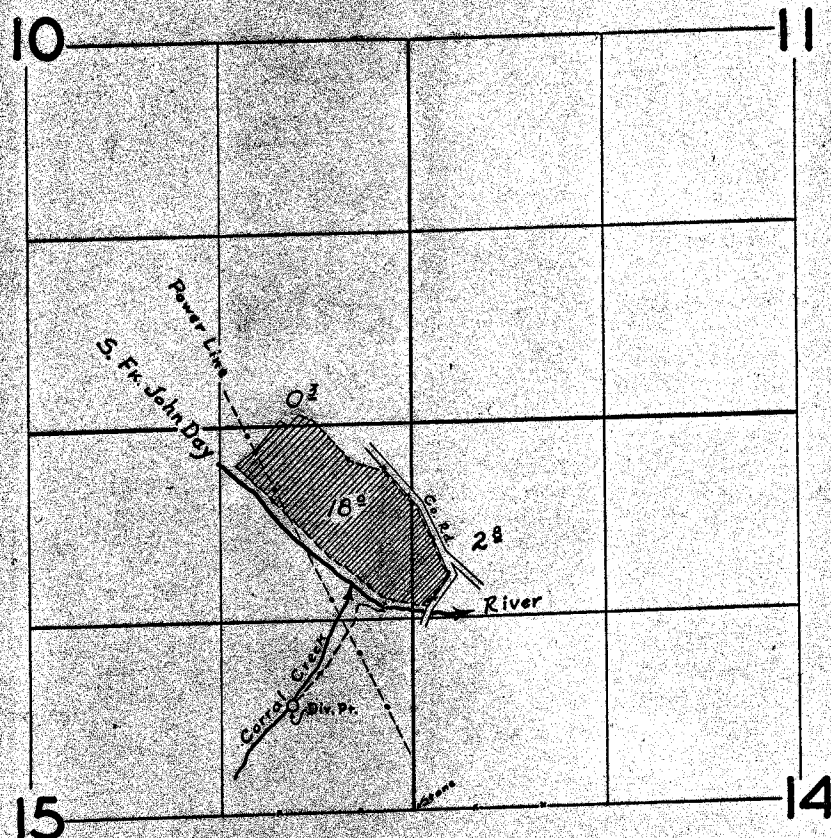

FINAL PROOF SURVEY

UNDER

Application No. 29616 Permit No. 23313

IN NAME OF
ABE RICKMAN

Surveyed AUG. 15 1959, by M. BISH

cert 27788