


T. 9S. R. 27E.W.M.

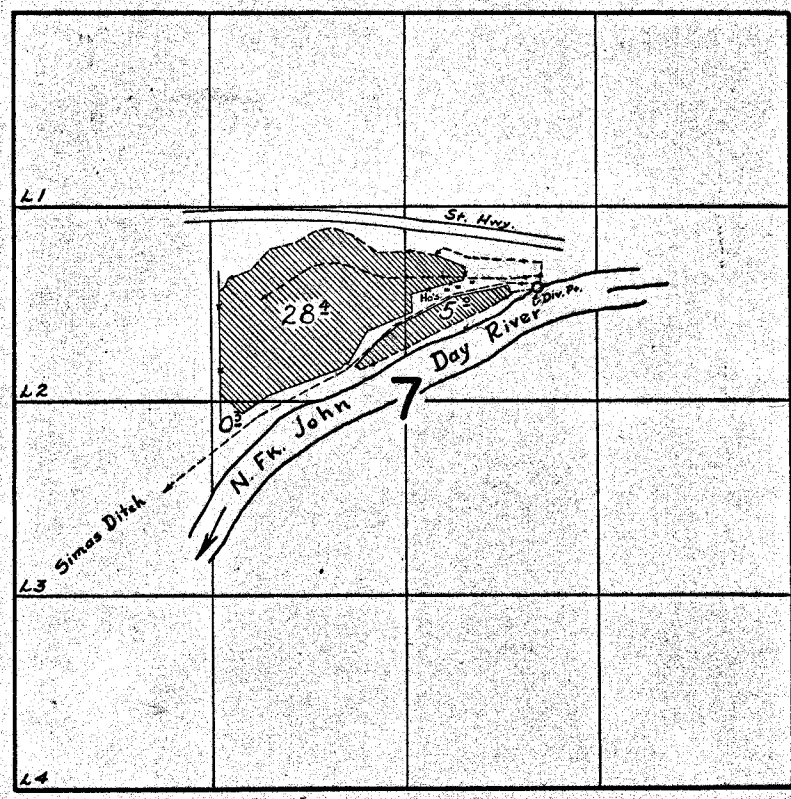

FINAL PROOF SURVEY

UNDER

Application No. 30638 Permit No. 24137

IN NAME OF

D. R. NEAL

Surveyed AUG. 12 1959, by M. BISH