


P-24891
27790

T. 12S. R. 34E. W.M.

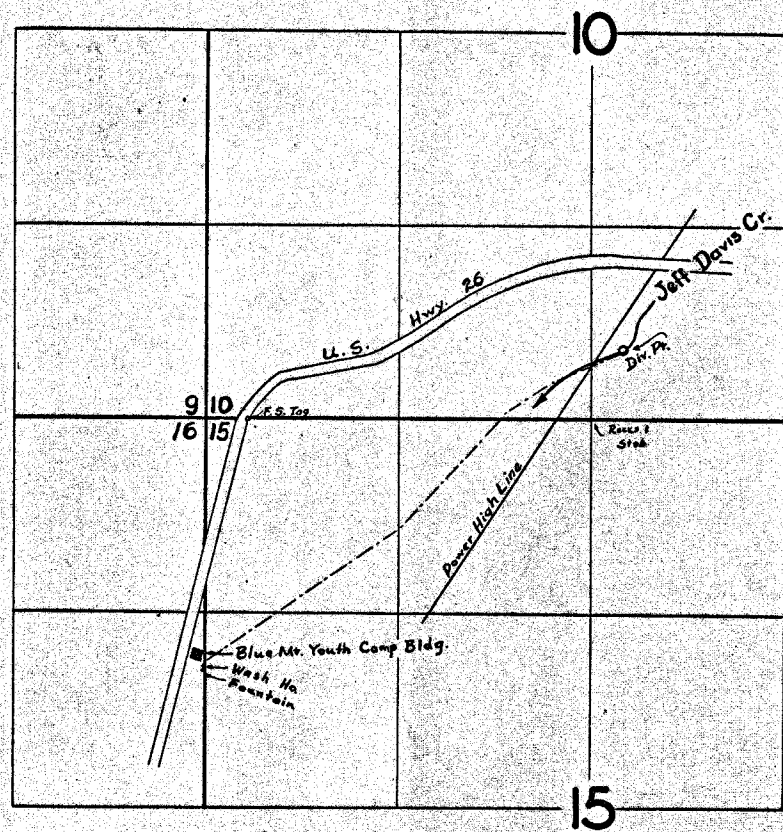

FINAL PROOF SURVEY
UNDER

Application No. 31521 Permit No. 24891
IN NAME OF
ASSEMBLIES OF GOD - OREGON DIST.
Surveyed Aug. 5 1959, by M. Bish