


On 25088
27791

T. 13S. R. 28E. W.M.

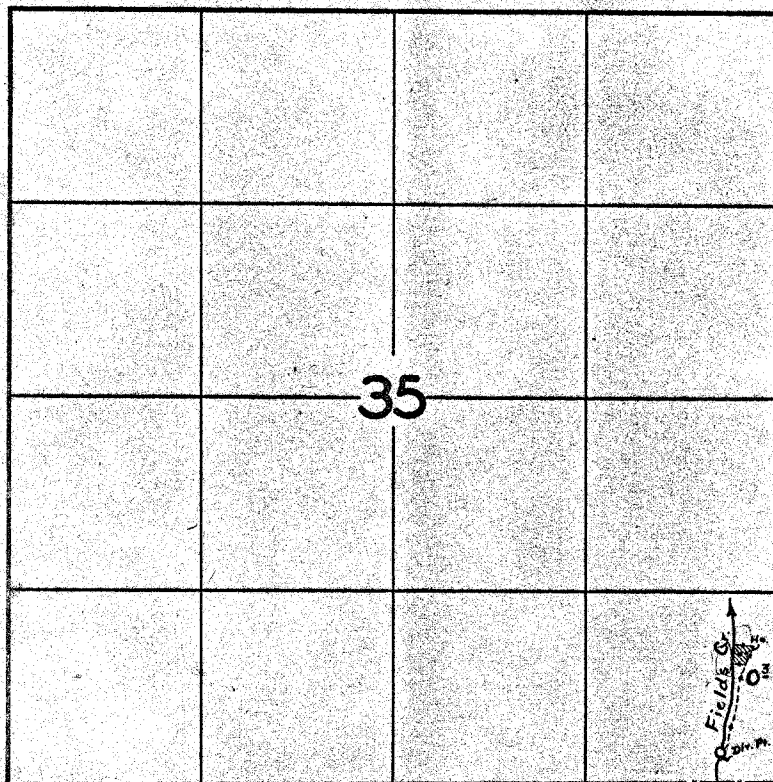

FINAL PROOF SURVEY
UNDER

Application No. 31771 Permit No. 25088
IN NAME OF

Wm. W. Fields

Surveyed Aug. 6 1959, by M. Bish