


Per. 25400
27792

T. 13S. R. 30 & 31 E. W.M.

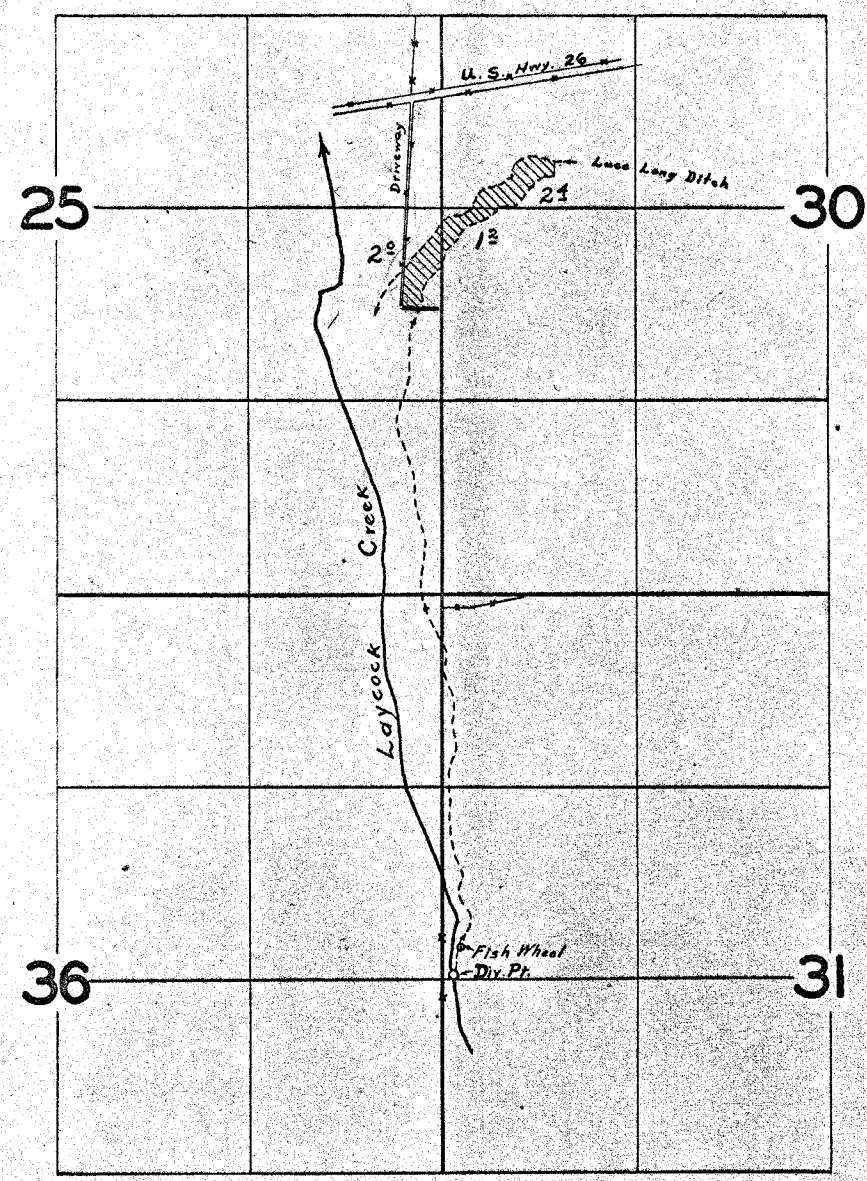

FINAL PROOF SURVEY UNDER

Application No. 32200. Permit No. 25400.
IN NAME OF

JOHN J. SILVERS

Surveyed AUG. 7. 1959, by M. BISH