


T.13S. R.12E.W.M.

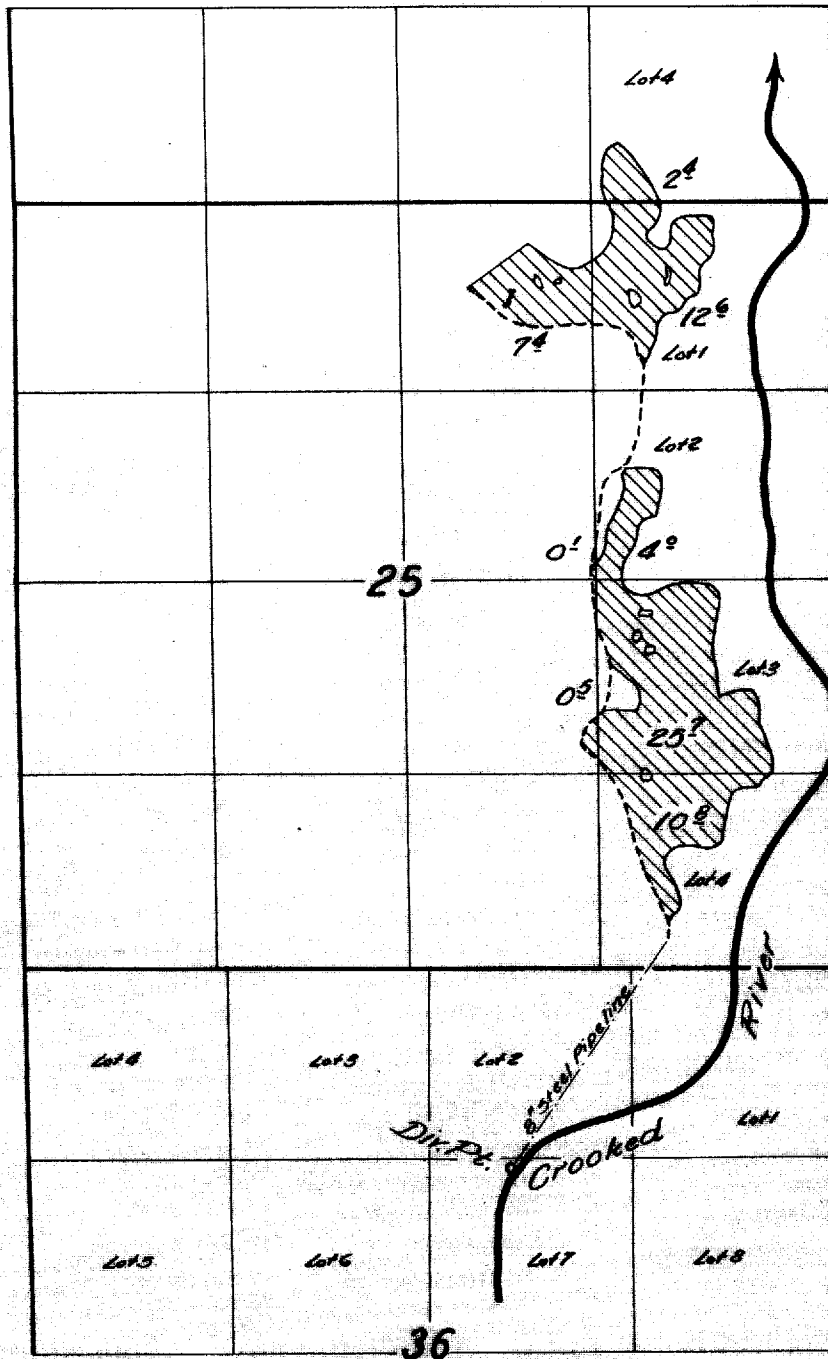

# FINAL PROOF SURVEY

UNDER

Application No. ~~30435~~ Permit No. ~~23903~~

IN NAME OF

C.R. Yunker

Surveyed June 19 1959, by Collaudo