


T.37 S.R.7 W.W.M.

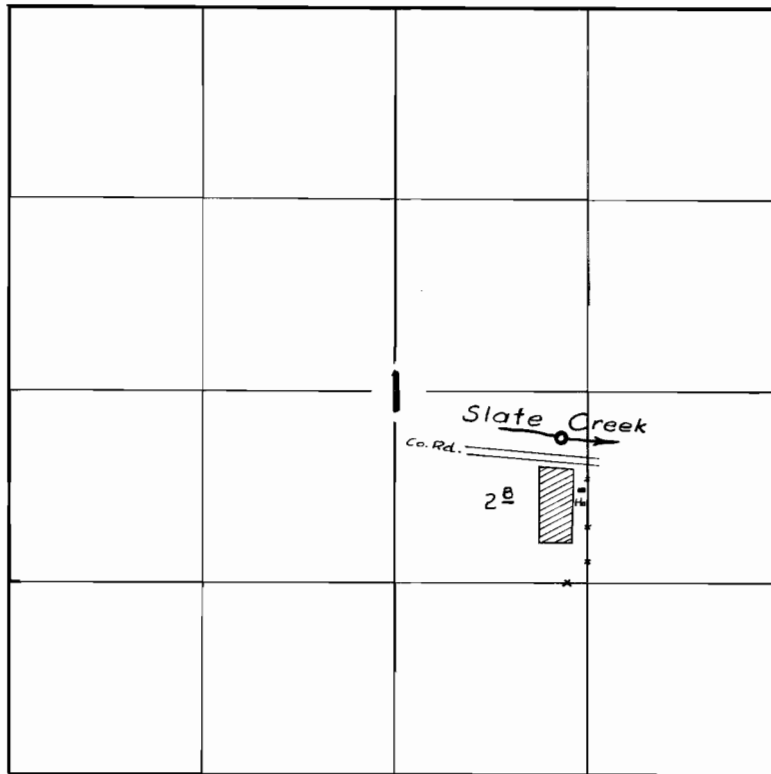

**FINAL PROOF SURVEY**  
UNDER

Application No. 29481 Permit No. 23195  
IN NAME OF

Everett N. Gray

Surveyed 22 July 1959, by M. B. Bish