


T. 34S. R. 7E. W.M.

Agency Lake well

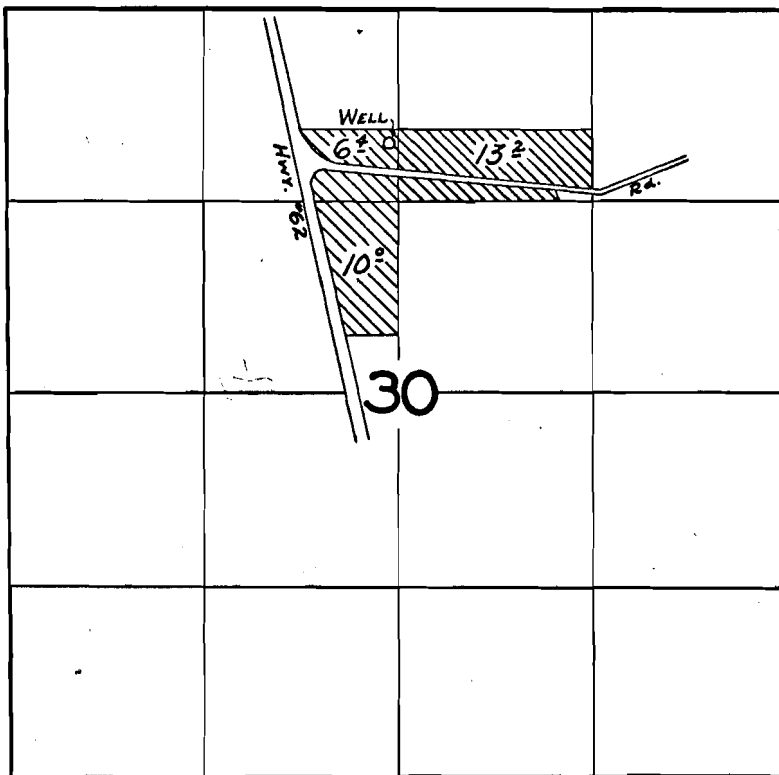

FINAL PROOF SURVEY UNDER

Application No. G-185 Permit No. G-122
IN NAME OF

RUFUS ROBINSON

Surveyed Oct. 15, 1959, by R. H. JACKSON