


U-463

2780L



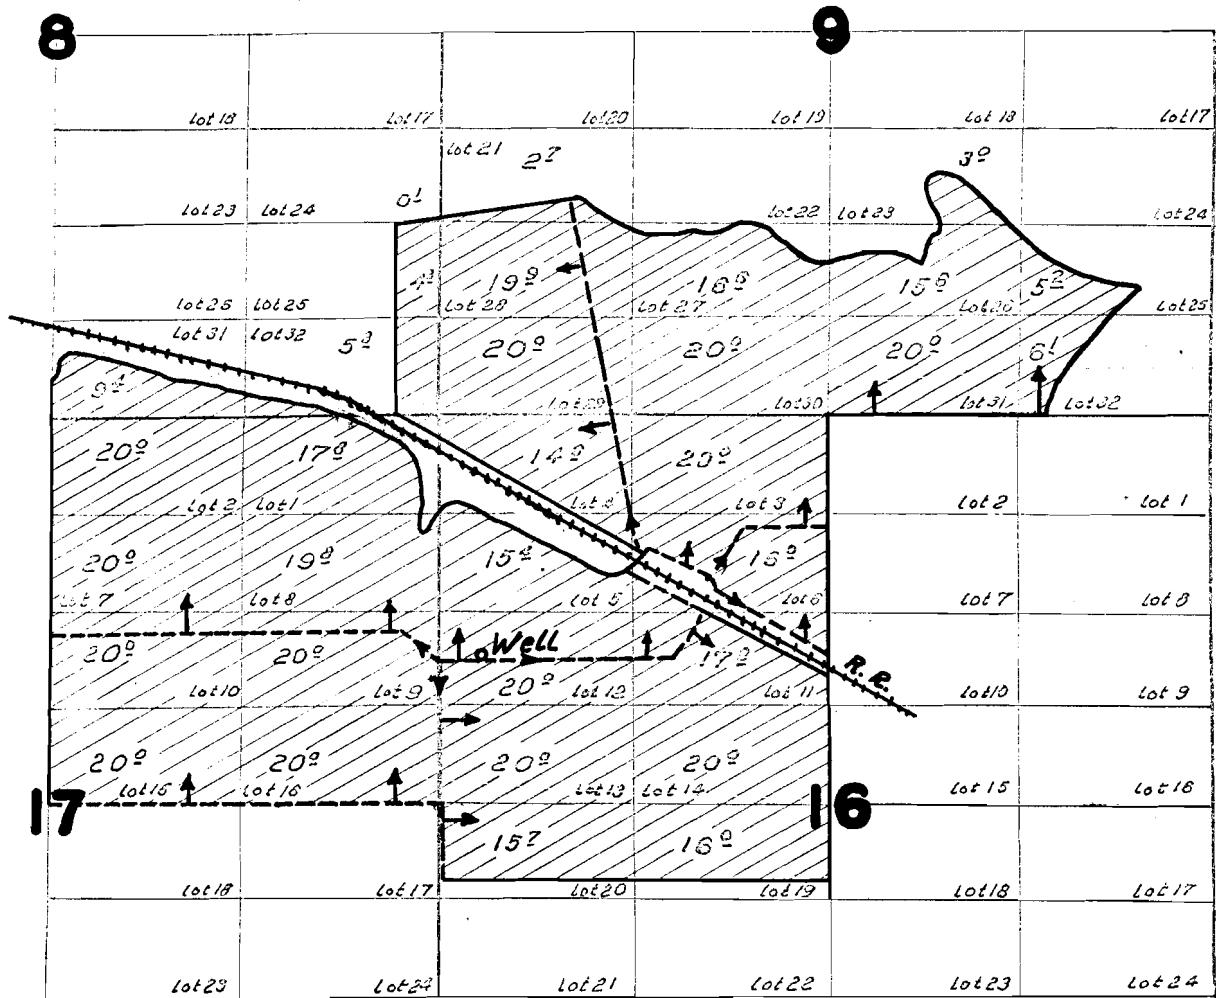

### FINAL PROOF SURVEY UNDER

Application No. U515..... Permit No. U-463.....  
IN NAME OF

.....Frank & Virginia Goularte.....

Surveyed Oct. 9... 1959, by R.H. Jackson.....

*[Signature]*  
CNO-76K-112