


# T.39 S.R.9 & 10 E.W.M.


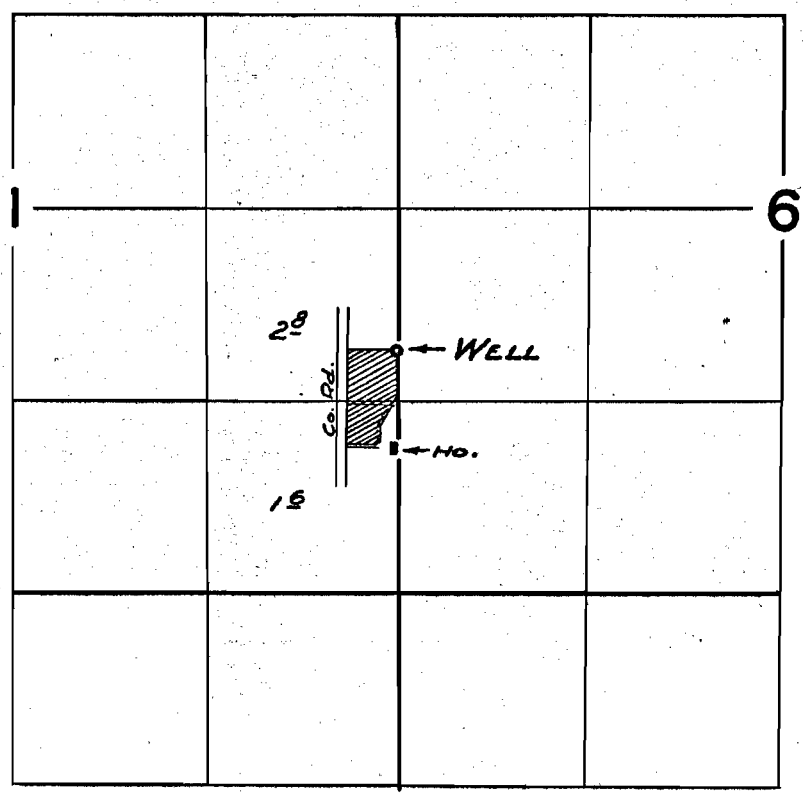

## FINAL PROOF SURVEY

UNDER

Application No. U-687 Permit No. U-630

IN NAME OF

Surveyed 26 Oct. 19 59, by Tr. Bick