


# MAP OF WOCUS RECLAMATION PROJECT IN KLAMATH COUNTY OREGON

T 38 S., R. 8 E., W. M.

Scale: 2" = 1 Mile

Sept., 1920.

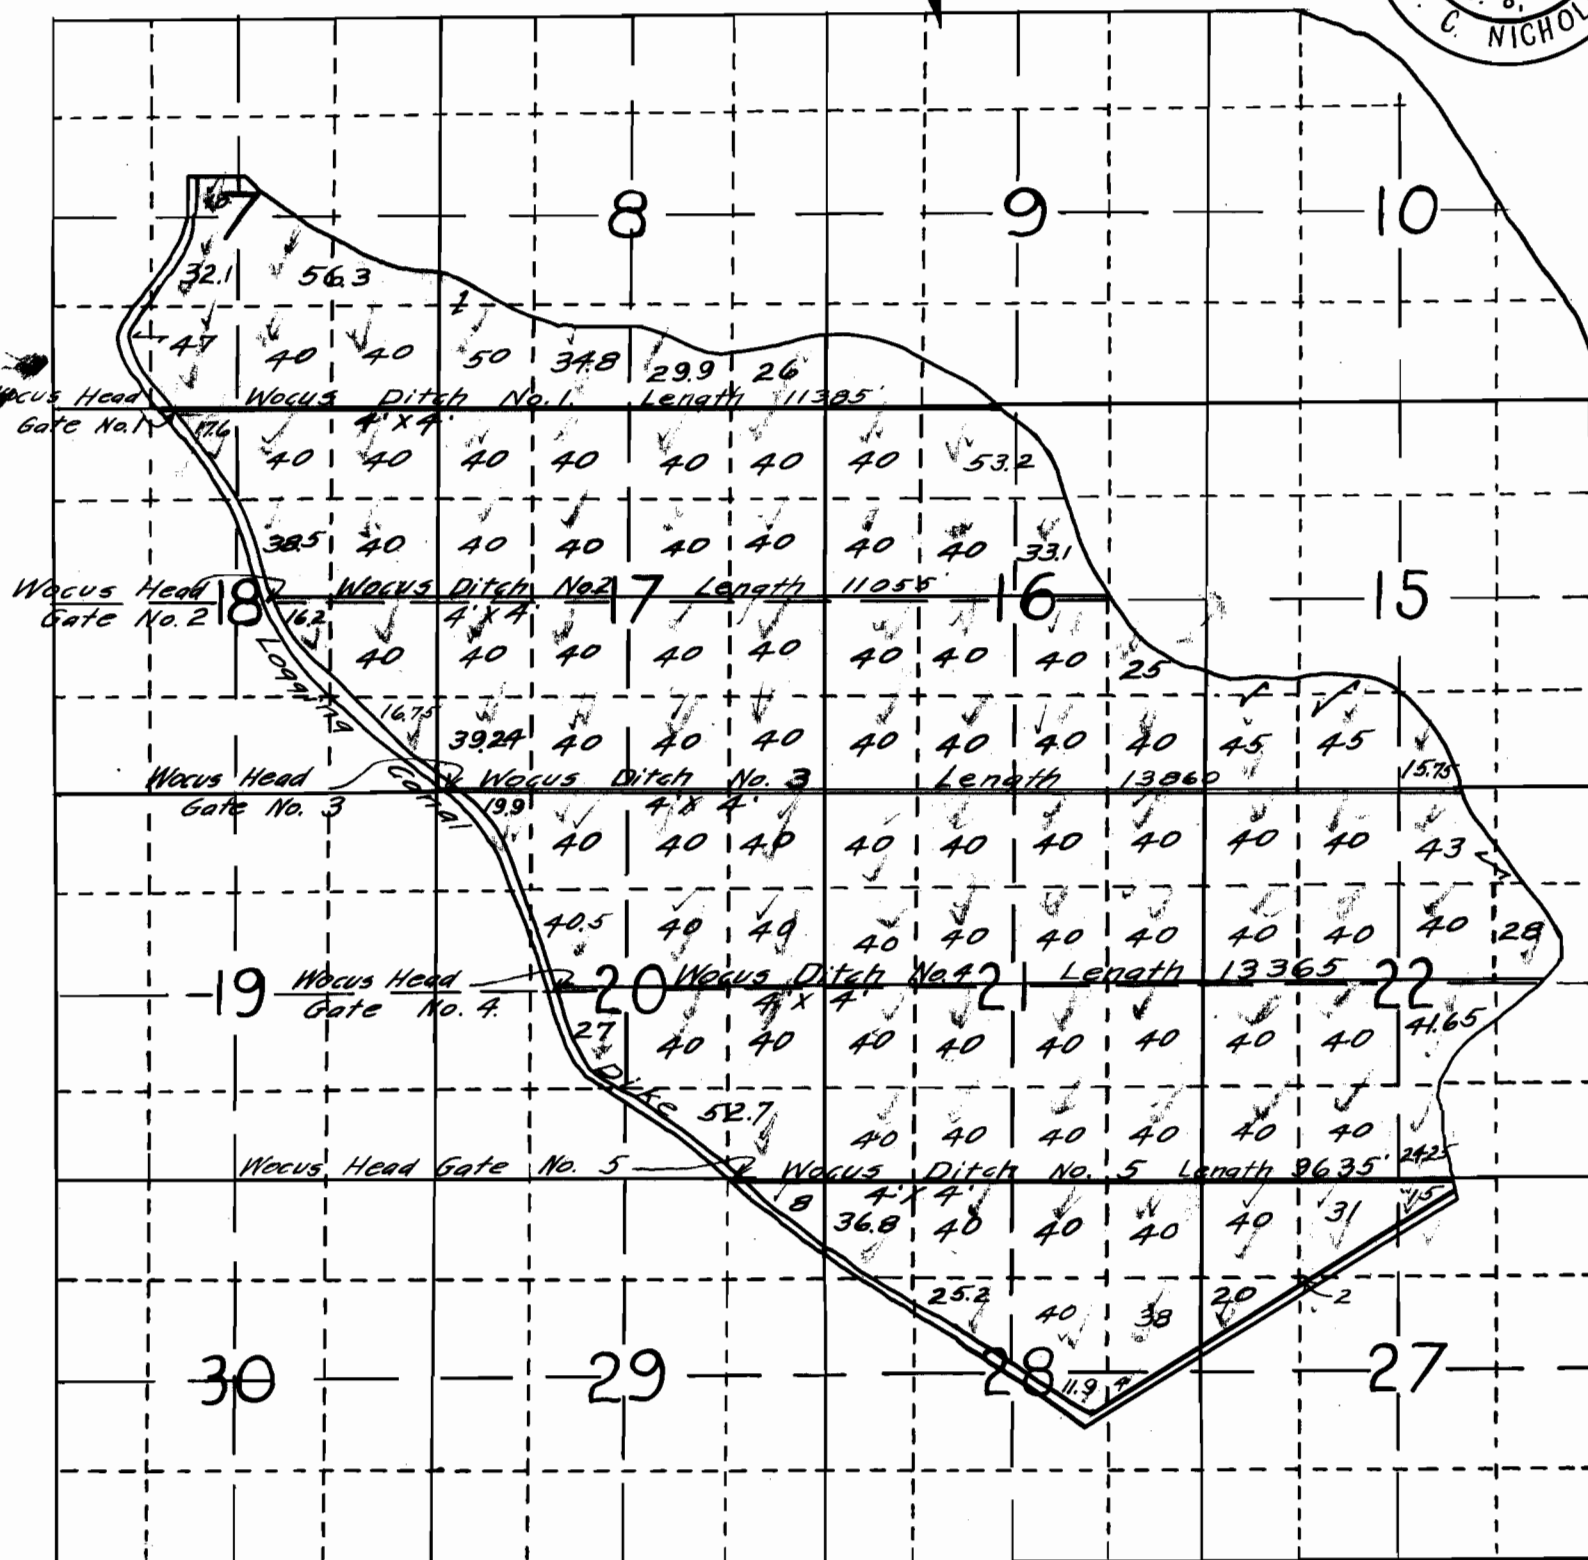


Application No. 6387  
Permit No. 4861

# MAP OF DIXON RECLAMATION PROJECT IN KLAMATH COUNTY OREGON

T. 38 S., R. 8 E., W. M.

Scale: 2" = 1 Mile

Sept., 1920.

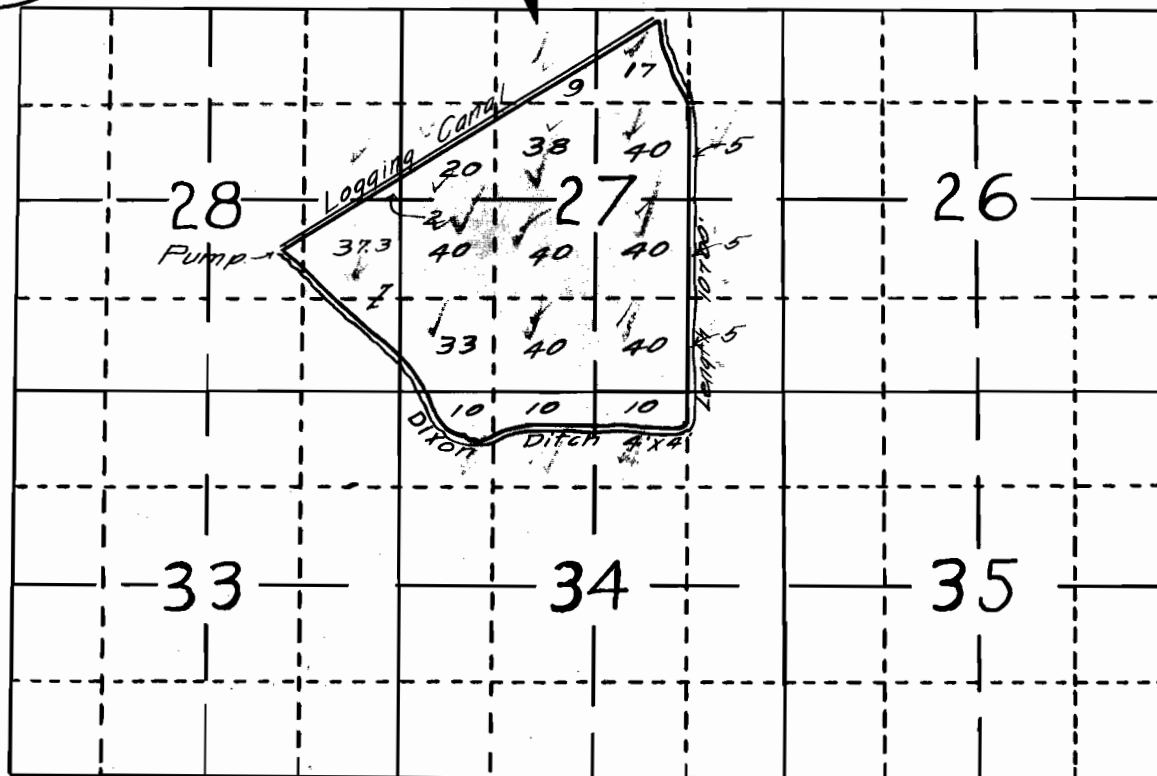

Application No. 6387  
Permit No. 4861

# MAP OF CALEDONIA RECLAMATION PROJECT IN KLAMATH COUNTY OREGON

Scale: 2" = 1 Mile

Aug. 10, 1920.



UPPER KLAMATH LAKE

Caledonia Gate No. 1.

Application No. 6387

KLAMATH


LAKE

OFFICE OF STATE ENGINEER

AUG 13 1920

SALE PM. OREGON

Application No. 6387  
Permit No. 4861

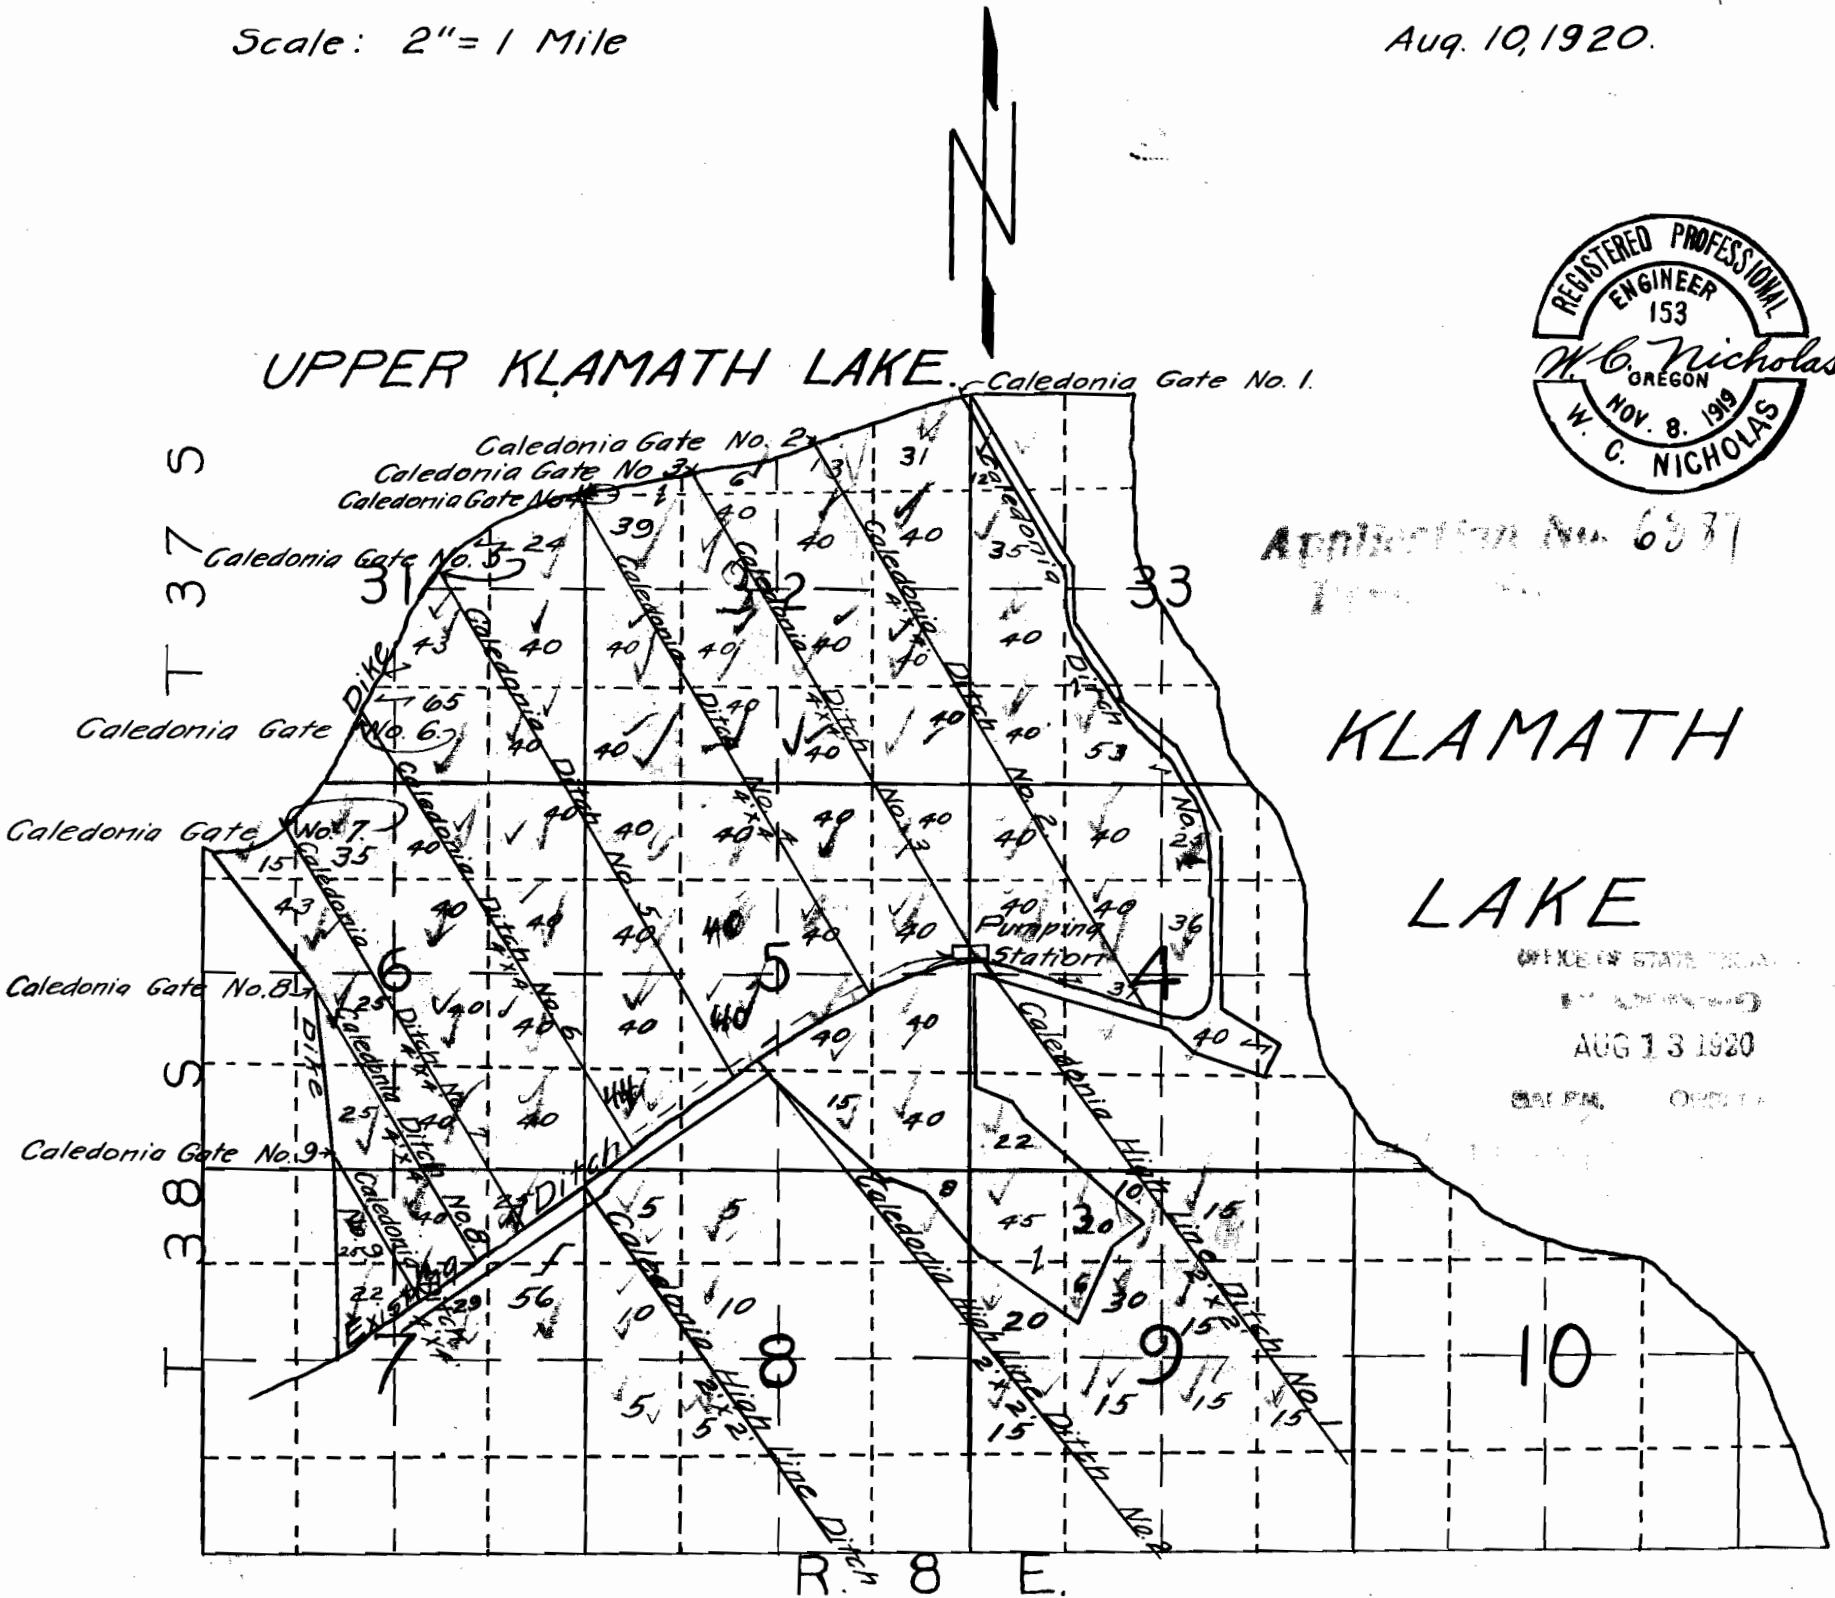


# MAP OF WILSON RECLAMATION PROJECT IN KLAMATH COUNTY OREGON

T. 38 S., R. 8 E., W.M.

Scale: 2" = 1 Mile

Sept., 1920.

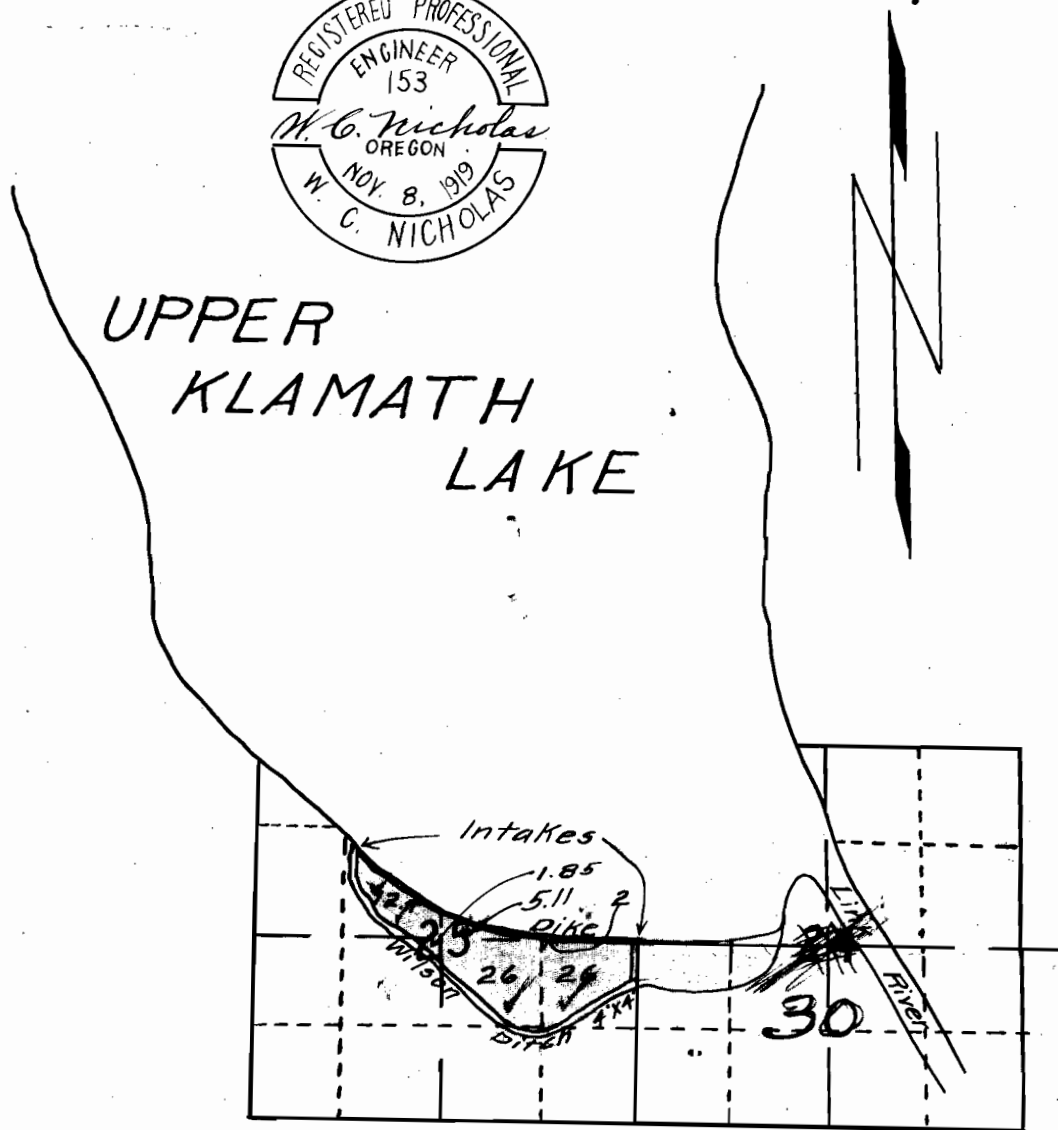

Application No

6387

Permit No

4861