


MAP OF WOCUS RECLAMATION PROJECT IN KLAMATH COUNTY OREGON

T 38 S., R. 8 E., W. M.

Scale: 2" = 1 Mile

Sept., 1920.

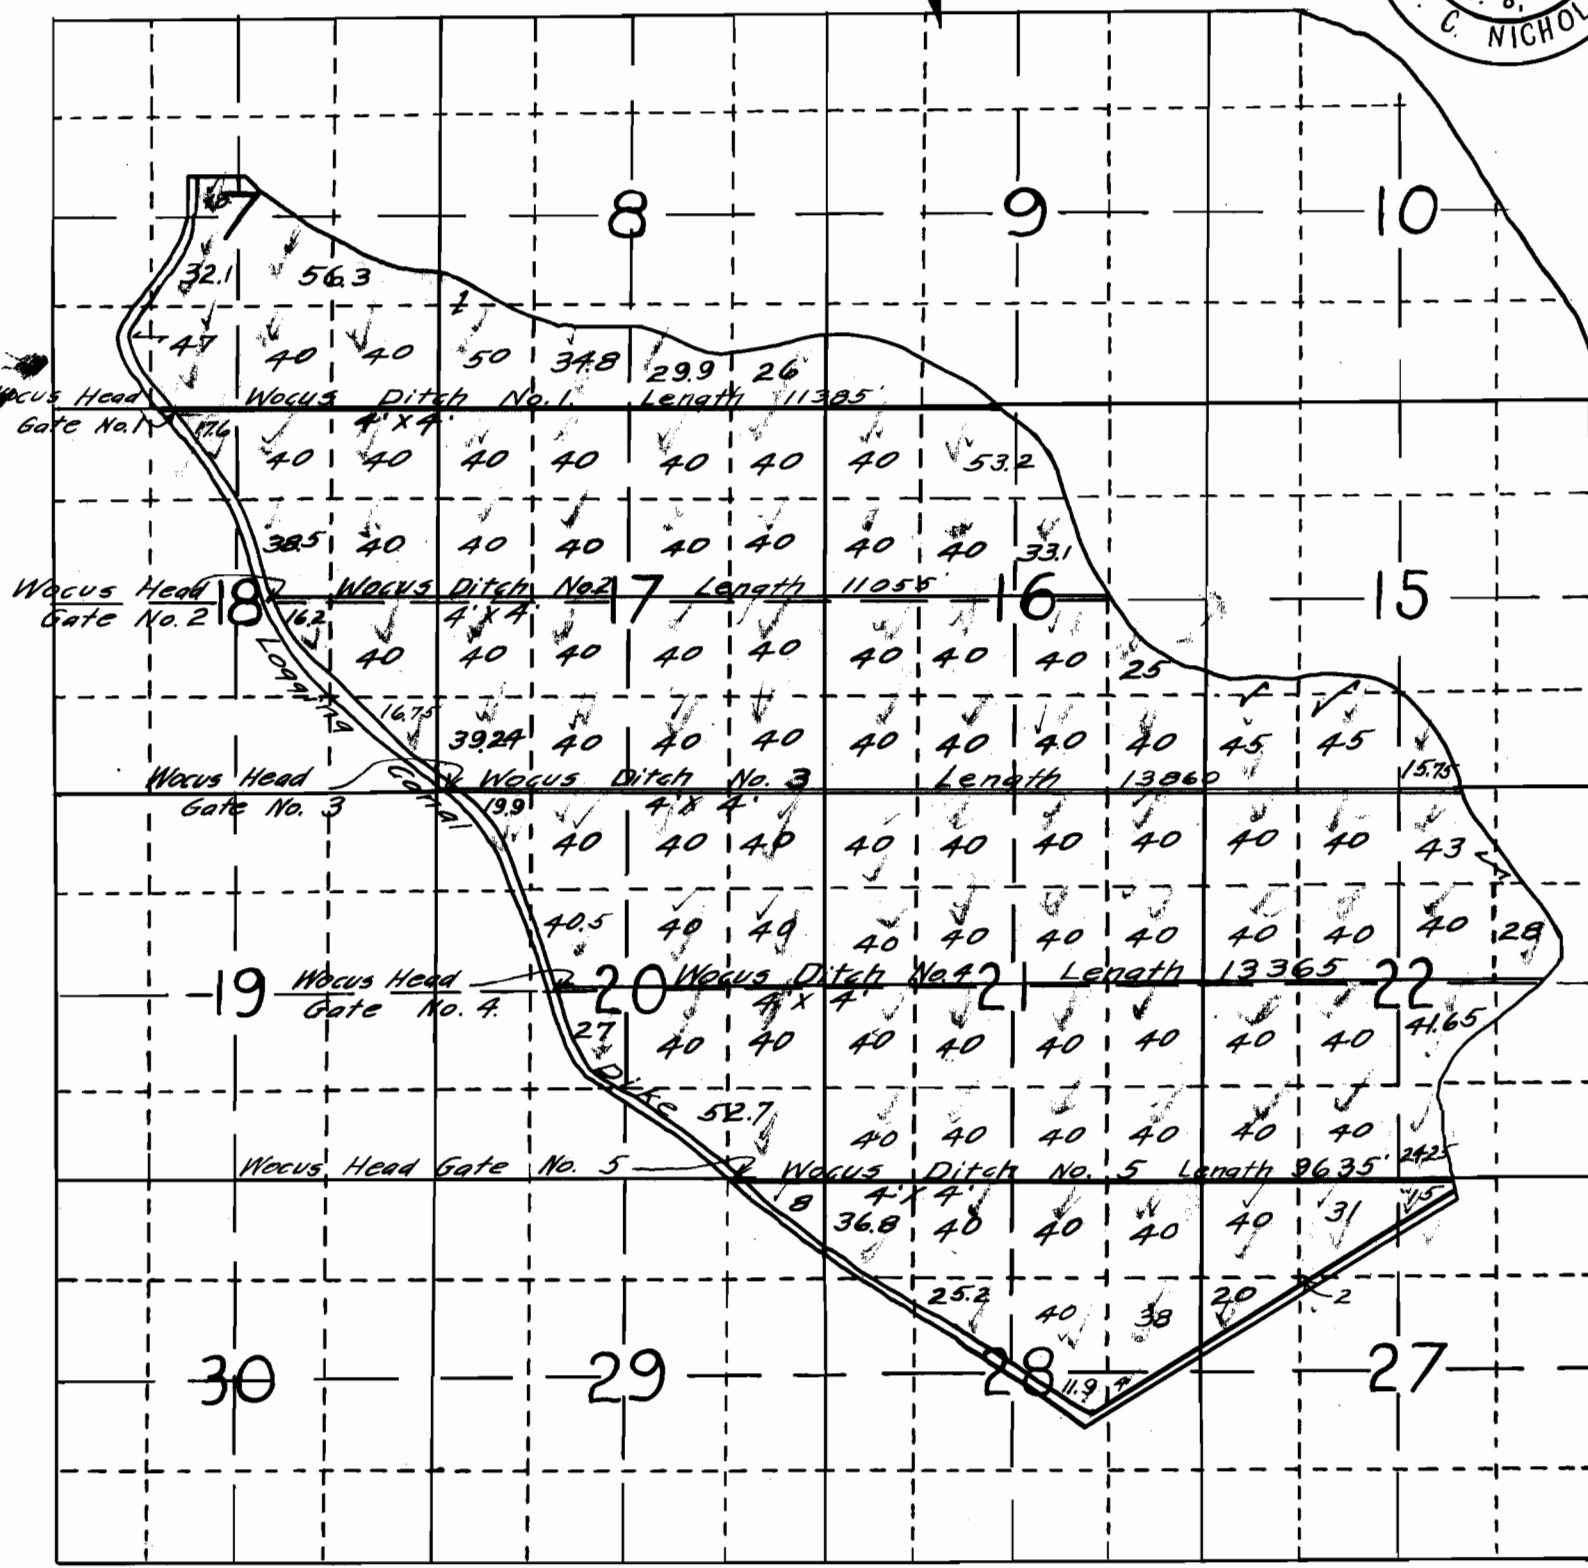


Application No. 6387
Permit No. 4861

MAP OF DIXON RECLAMATION PROJECT IN KLAMATH COUNTY OREGON

T. 38 S., R. 8 E., W. M.

Scale: 2" = 1 Mile

Sept., 1920.

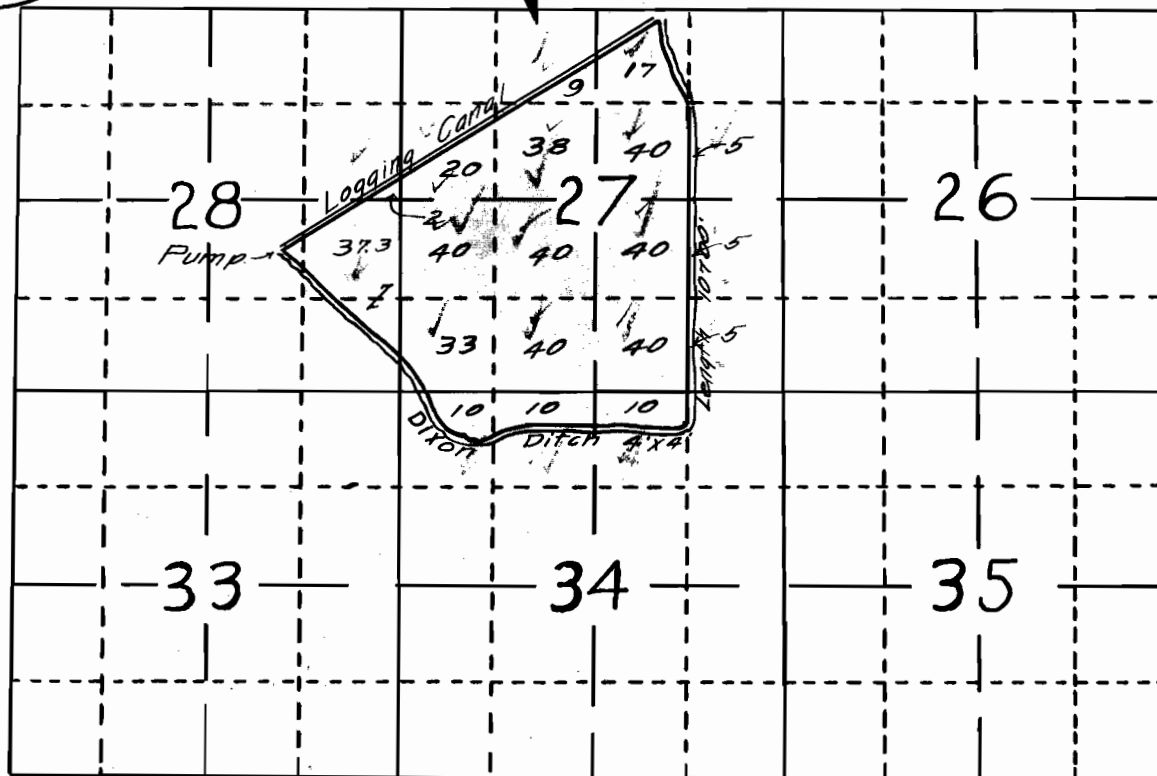

Application No. 6387
Permit No. 4861

MAP OF CALEDONIA RECLAMATION PROJECT IN KLAMATH COUNTY OREGON

Scale: 2" = 1 Mile

Aug. 10, 1920.



UPPER KLAMATH LAKE

Caledonia Gate No. 1.

Application No. 6387


KLAMATH

LAKE

OFFICE OF STATE ENGINEER

AUG 13 1920

SALE PM. OREGON

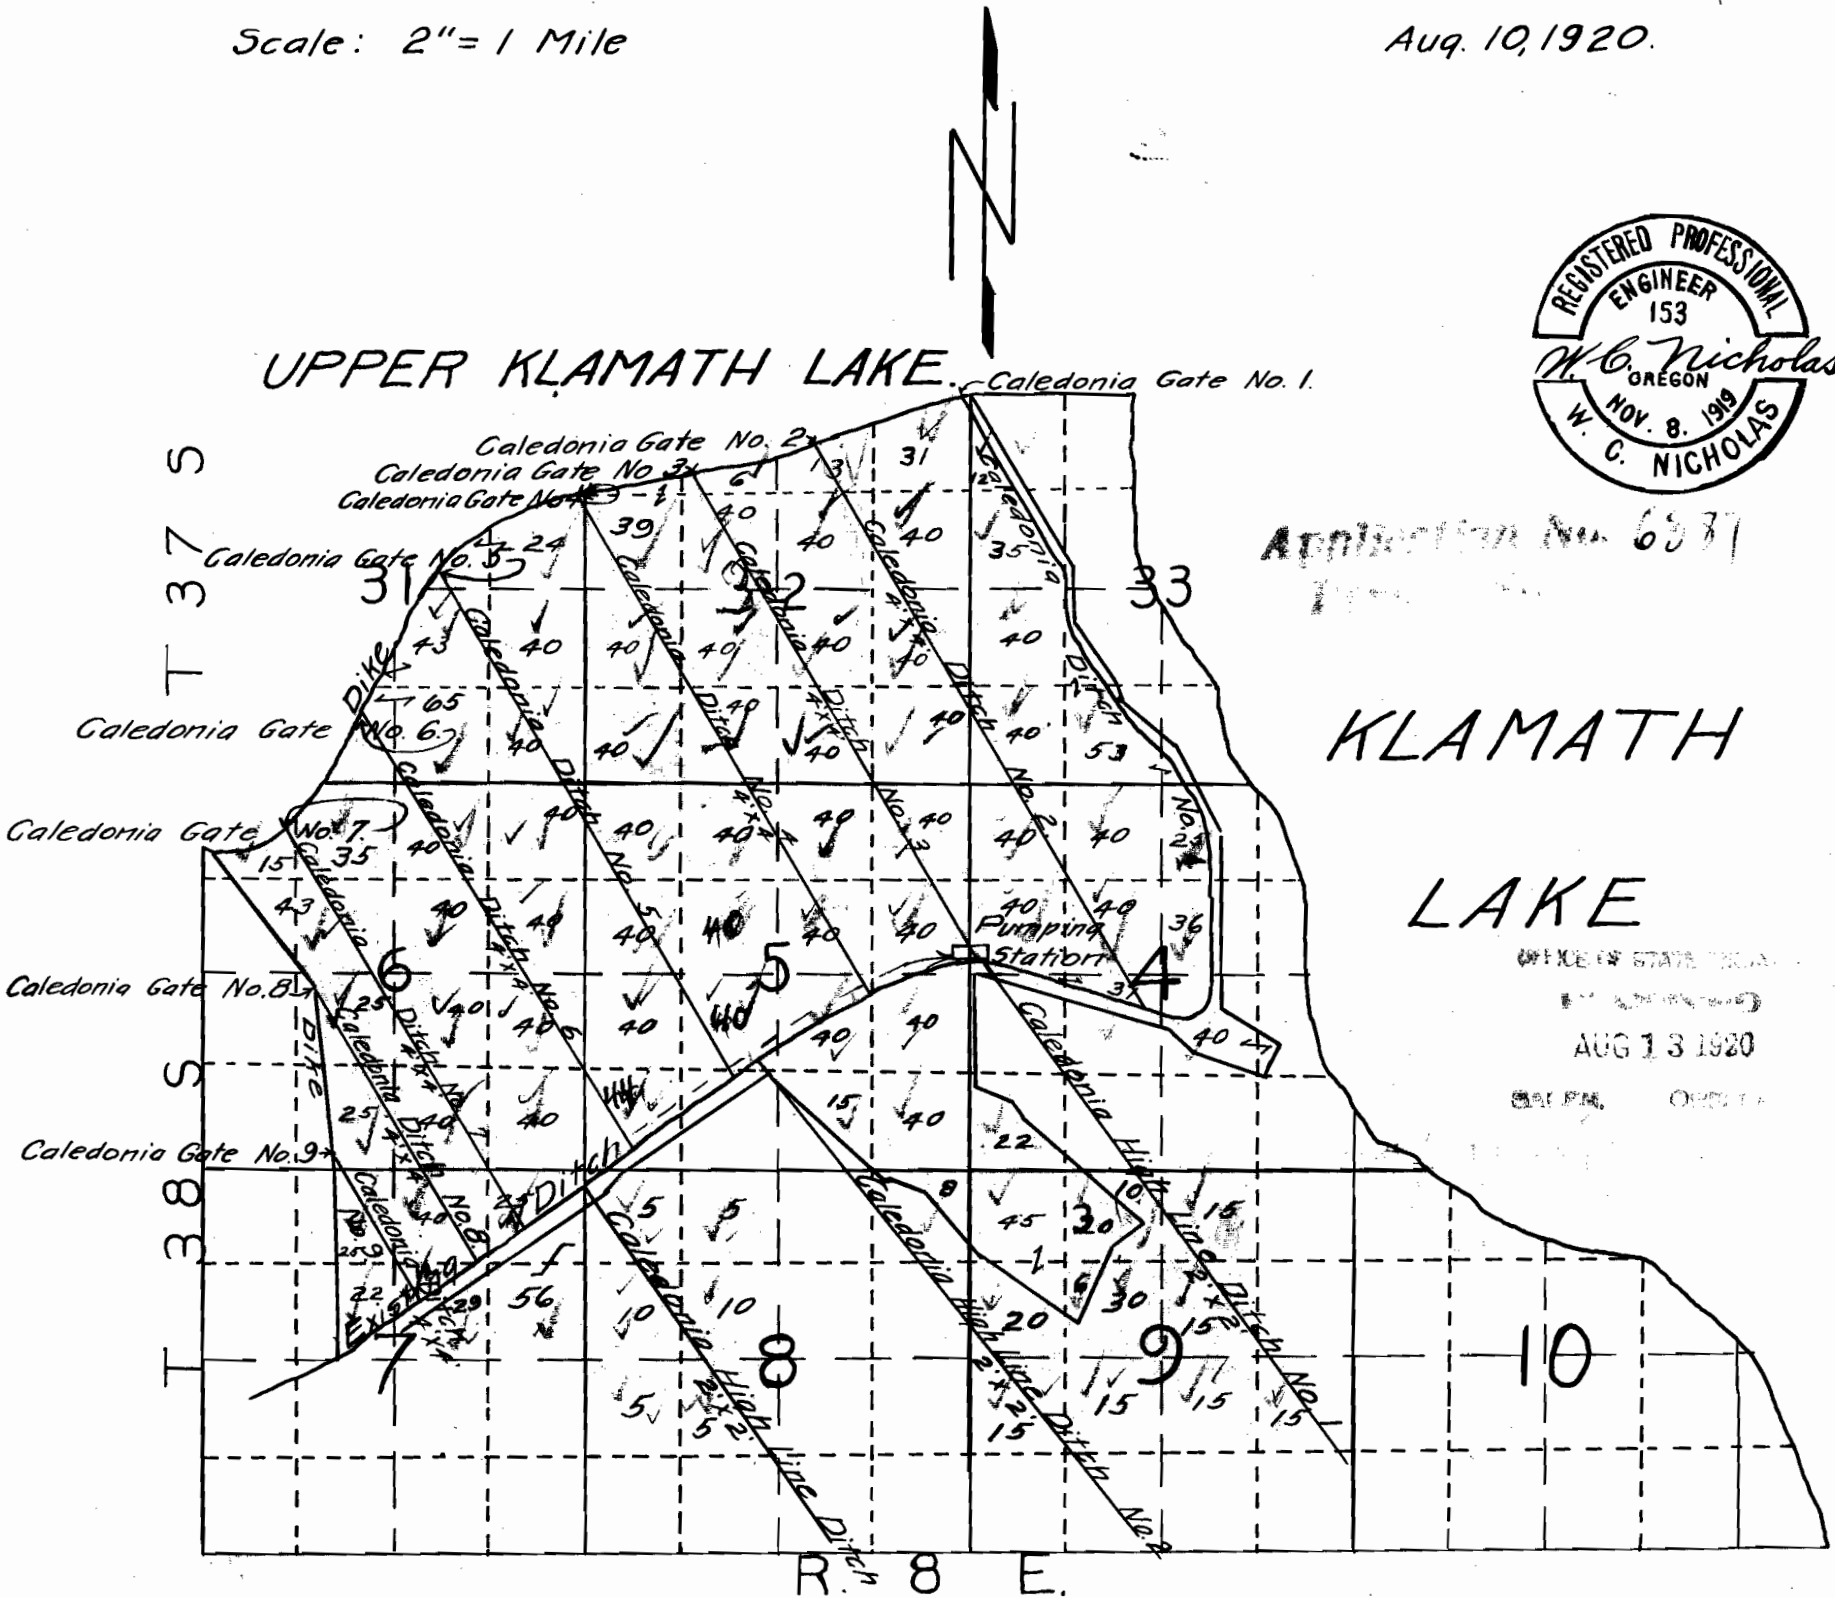

Application No. 6387


Permit No. 4861

MAP OF WILSON RECLAMATION PROJECT IN KLAMATH COUNTY OREGON

T. 38 S., R. 8 E., W.M.

Scale: 2" = 1 Mile

Sept., 1920.

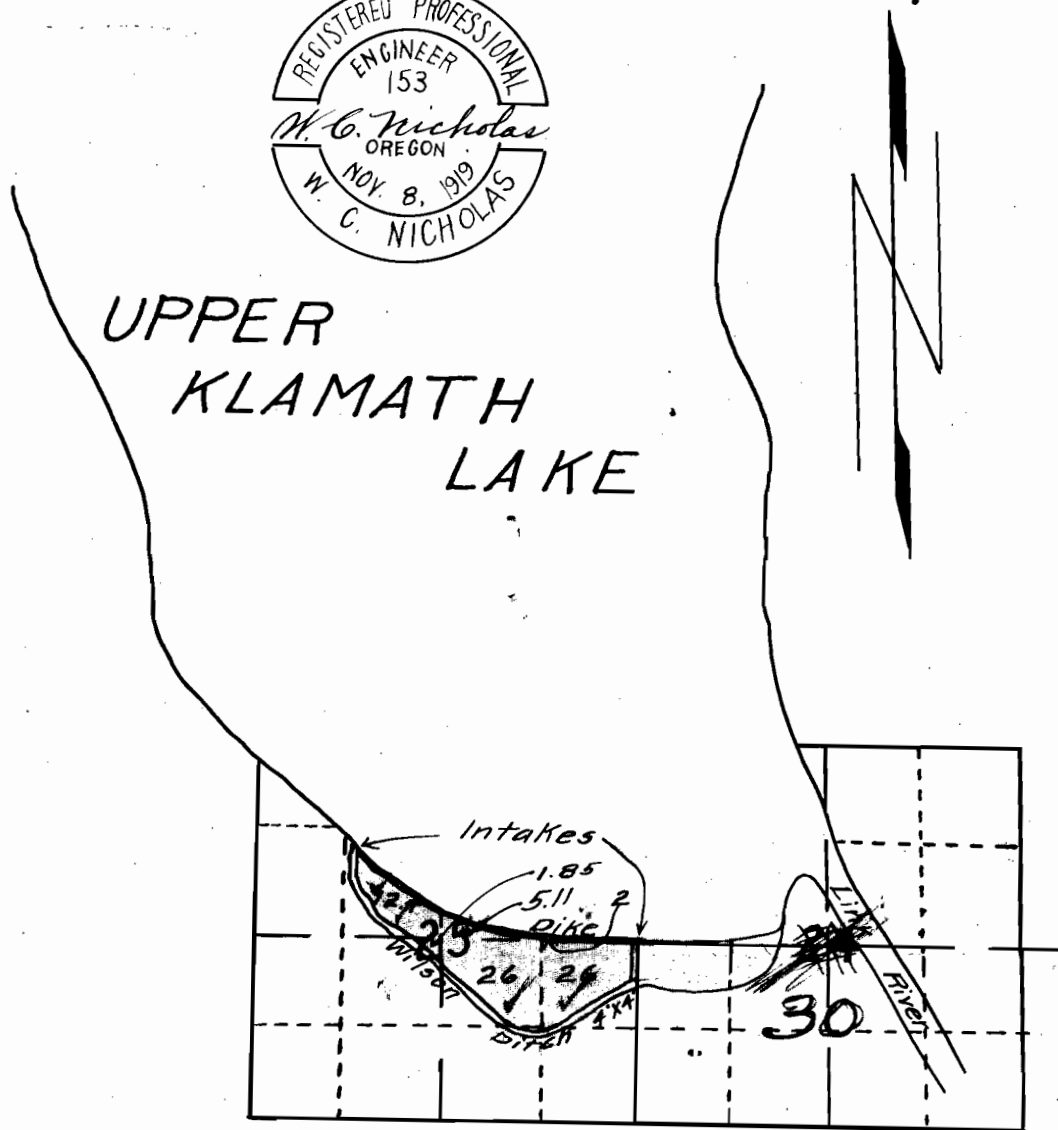

Application No

6387

Permit No

4861