


T. 34S.R. 6E.W.M.

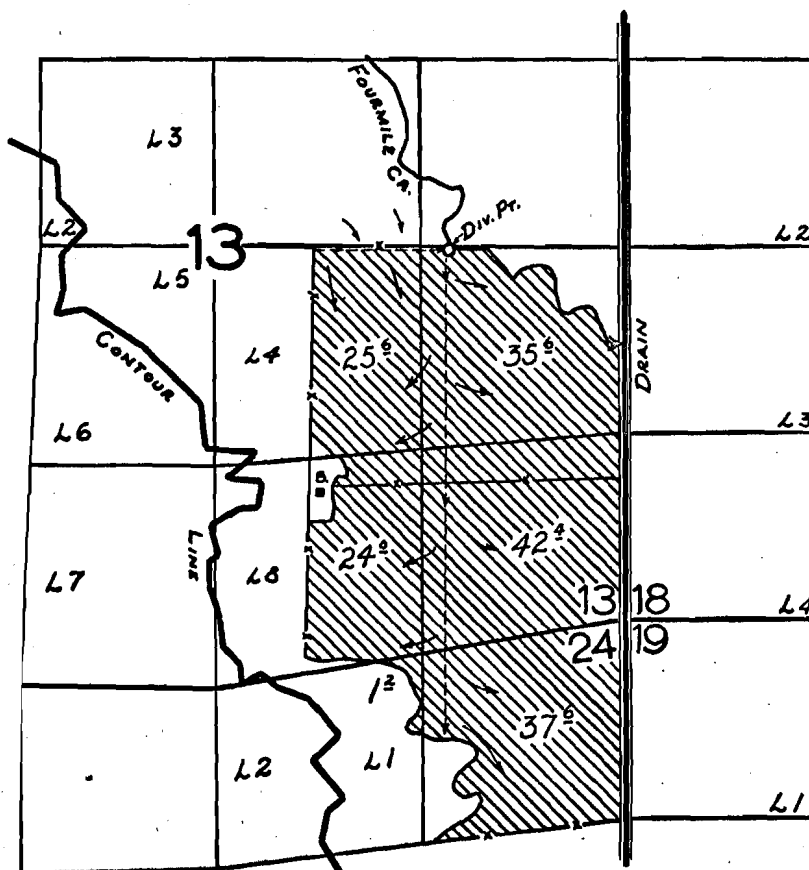

# FINAL PROOF SURVEY

UNDER

Application No. 29798 Permit No. 23451  
IN NAME OF

HENRY & JUNE F. GRIMES

Surveyed Oct. 8 1959, by R. H. JACKSON