


# T.17S.R.1&2E.W.M.

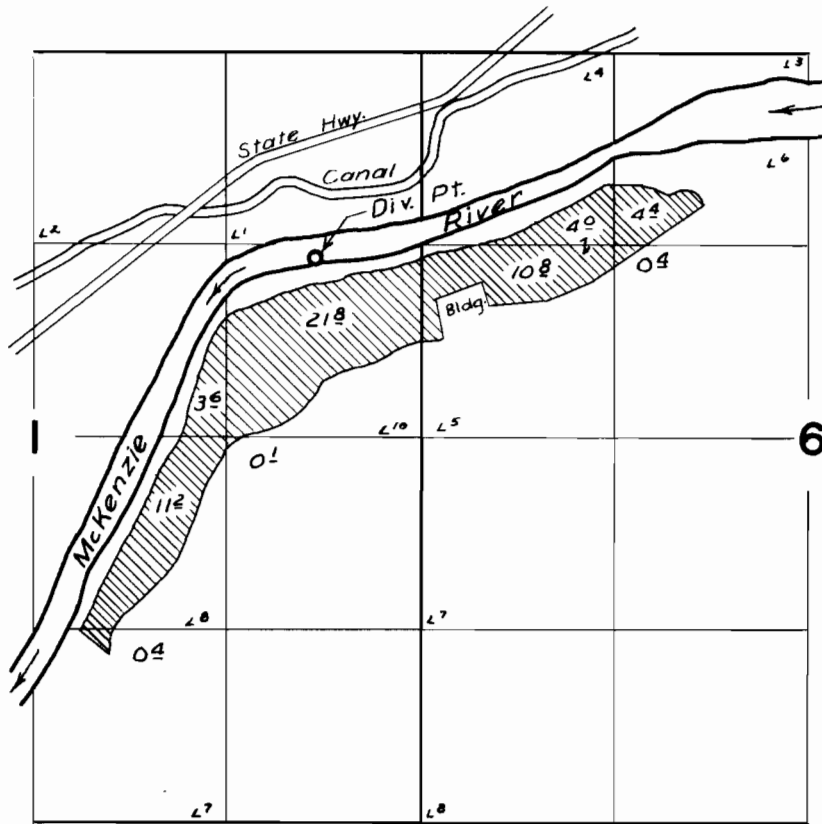

## FINAL PROOF SURVEY

UNDER

Application No. 22911 . . . Permit No. 18064 . . .

IN NAME OF

*Albert L. Hawn and Dorothy N. Hawn*

Surveyed *May 7 1954*, by *T. Jones* . . . . .