


T.18 S. R.5 W. W.M.

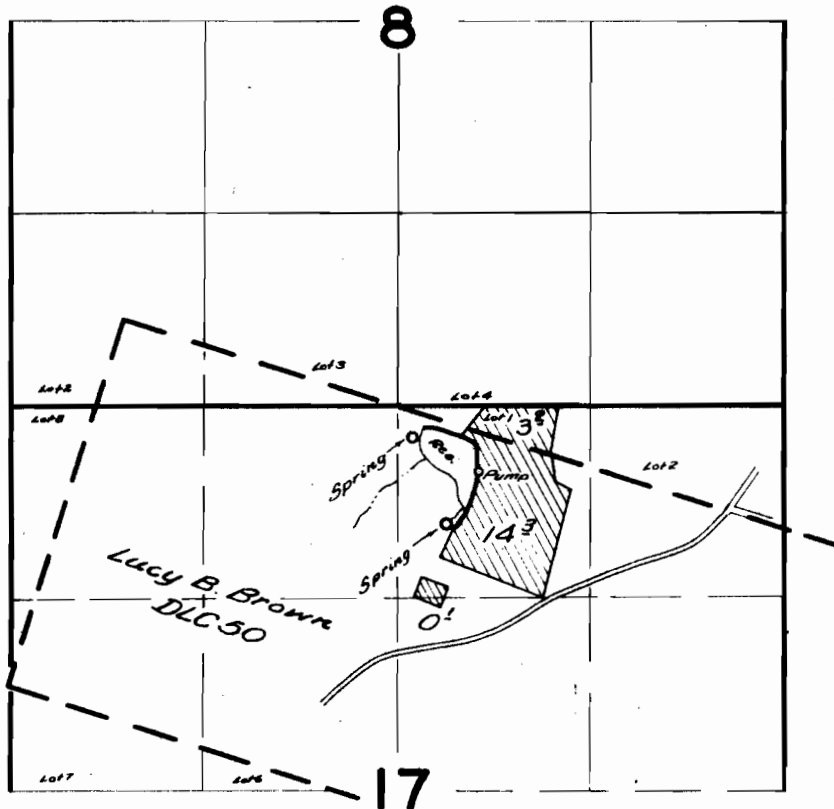

FINAL PROOF SURVEY
UNDER

Application No. *R-25348* Permit No. *R-1137*
25474 *20219*
IN NAME OF

Herbert Youngblood

Surveyed *April 1* 1959, by *C.O. Baile*