


T.18 S. R.5 W. W.M.

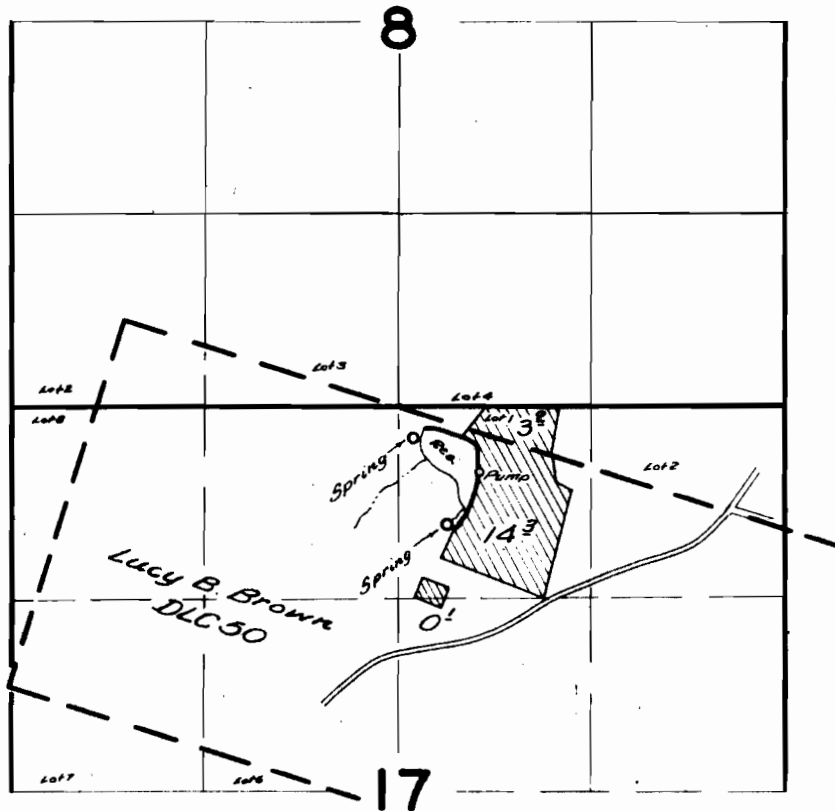

FINAL PROOF SURVEY
UNDER

Application No. ^{R-25348} ~~25474~~ Permit No. ^{R-1137} ~~20219~~
IN NAME OF

Herbert Youngblood

Surveyed *April 1* 1959, by *C.O. Bault*