


T. 18S. R. 2W. W.M.

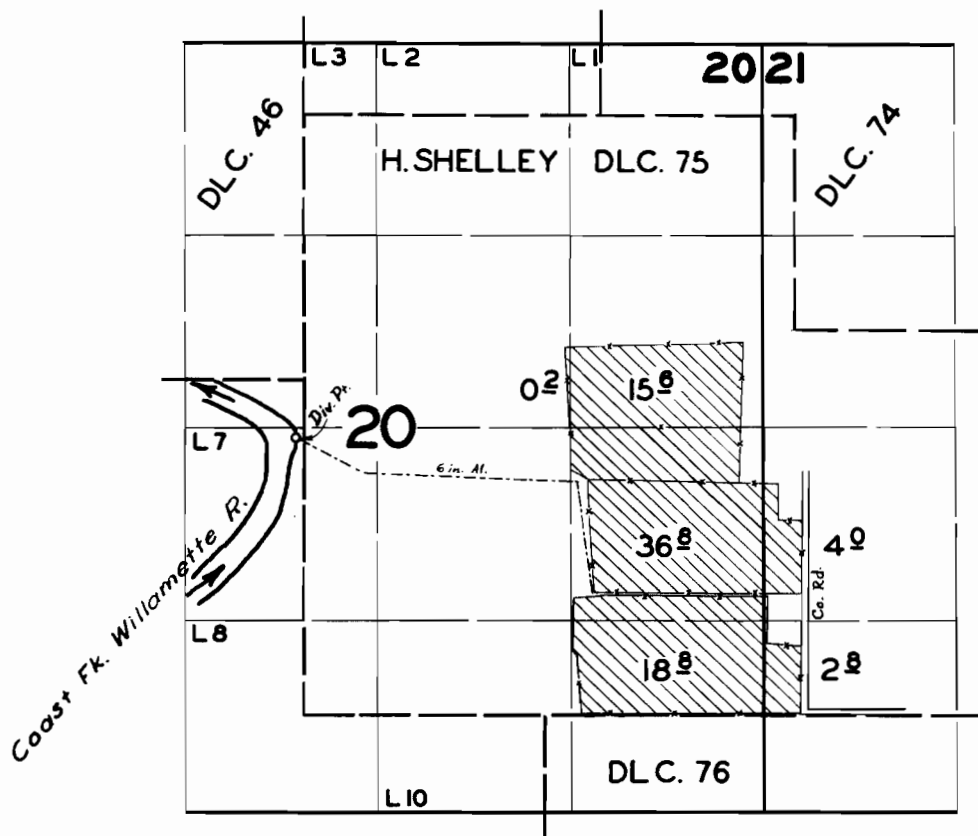

FINAL PROOF SURVEY
UNDER

Application No. 29898 Permit No. 23410
IN NAME OF

MILTON V. WALKER M.D.

Surveyed MAR. 27 1959, by M. BISH