


T. 19S. R. 4W. W.M.

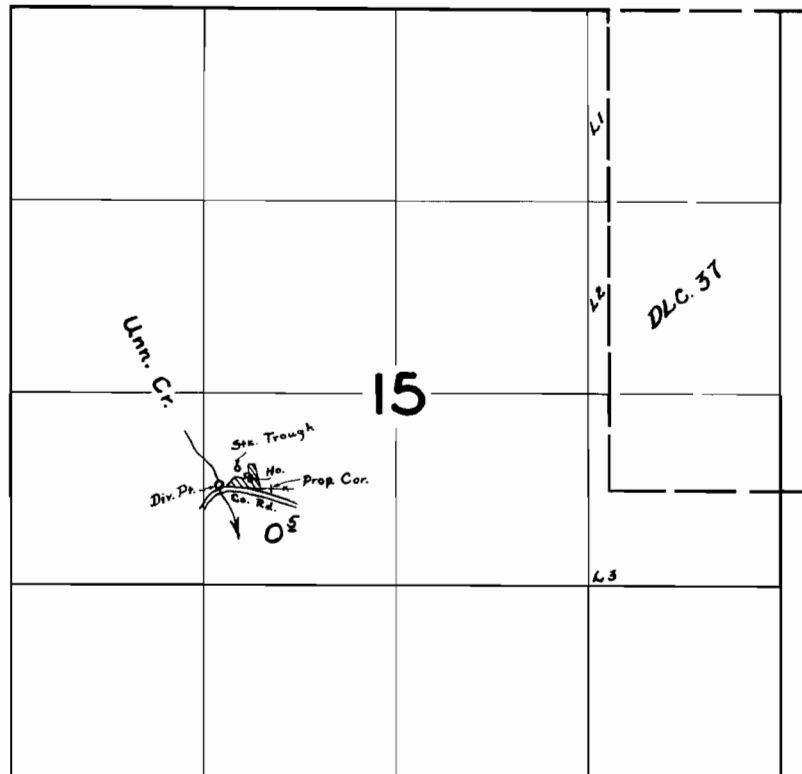

**FINAL PROOF SURVEY**  
UNDER

Application No. 29781... Permit No. 23575  
IN NAME OF

**VIRGINIA C. WOOD**

Surveyed MAR. 31 1959, by M. BISH