


T.18S. R.5W.W.M.

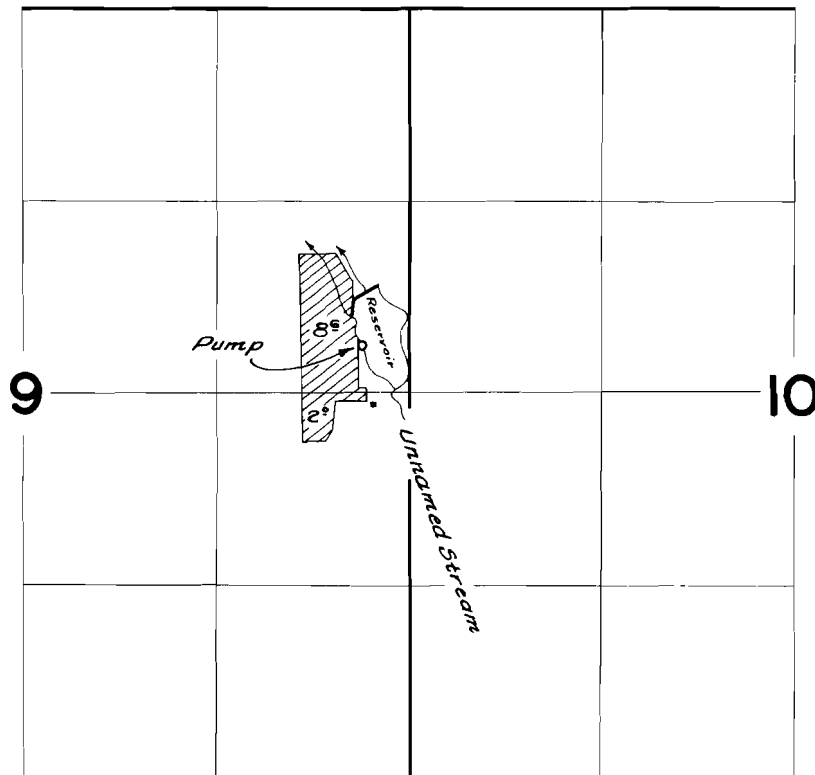

**FINAL PROOF SURVEY**  
UNDER

Application No. R-30004 30005 Permit No. R-1752 23630  
IN NAME OF

JOHN GRIFFELTH

Surveyed March 30 1959, by C.O. Bartlett