


T. 18S. R. 2W. W.M.

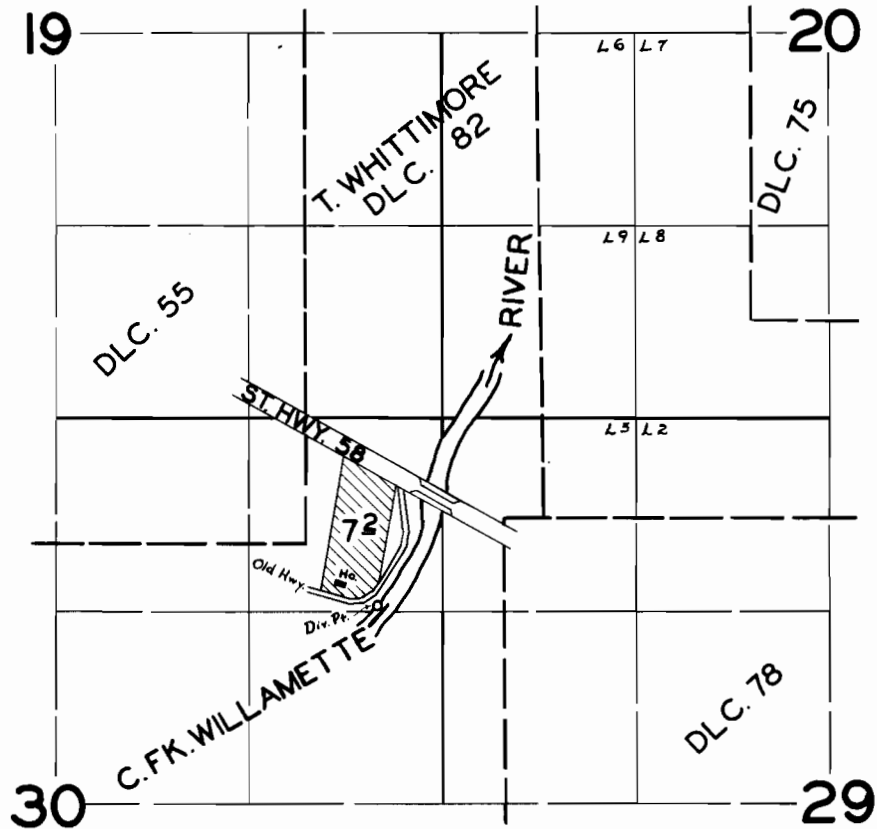

**FINAL PROOF SURVEY**  
UNDER

Application No. 30169 Permit No. 23794  
IN NAME OF

..... DONALD R. JOHNSON .....

Surveyed MAR. 25 1959, by M. BISH .....