


T.18 S. R.6 W.W.M.

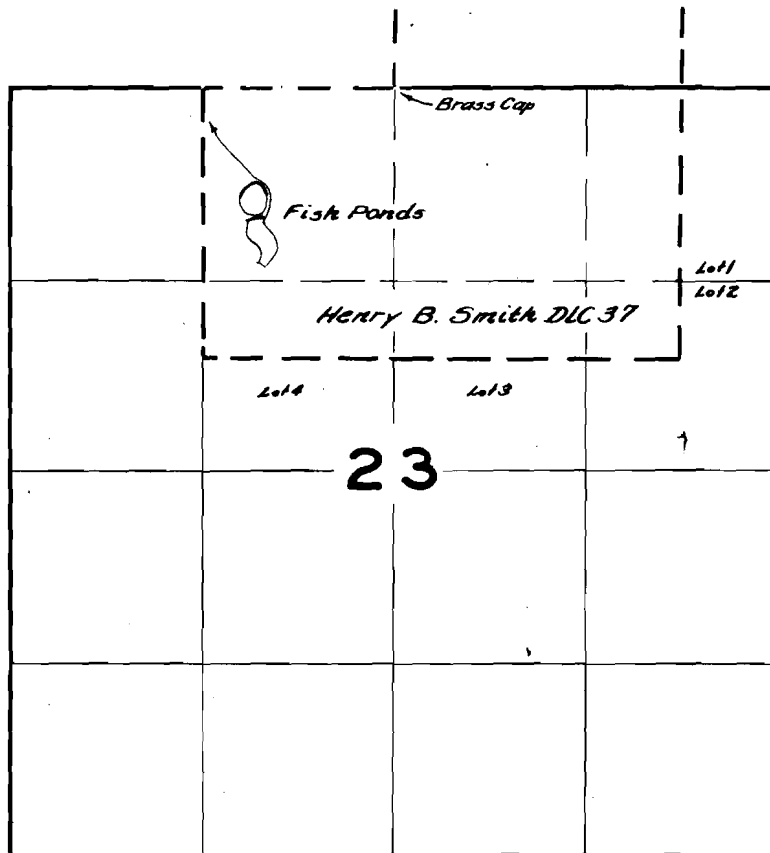

FINAL PROOF SURVEY
UNDER

Application No. *32735*
R-32734 Permit No. *25891*
30507 *R-2208*
R-30138 *24021*
R-1818
IN NAME OF

Marue C. & Cora A. Carroll

Surveyed *March 26* 1959, by *C.C. Bartels*