


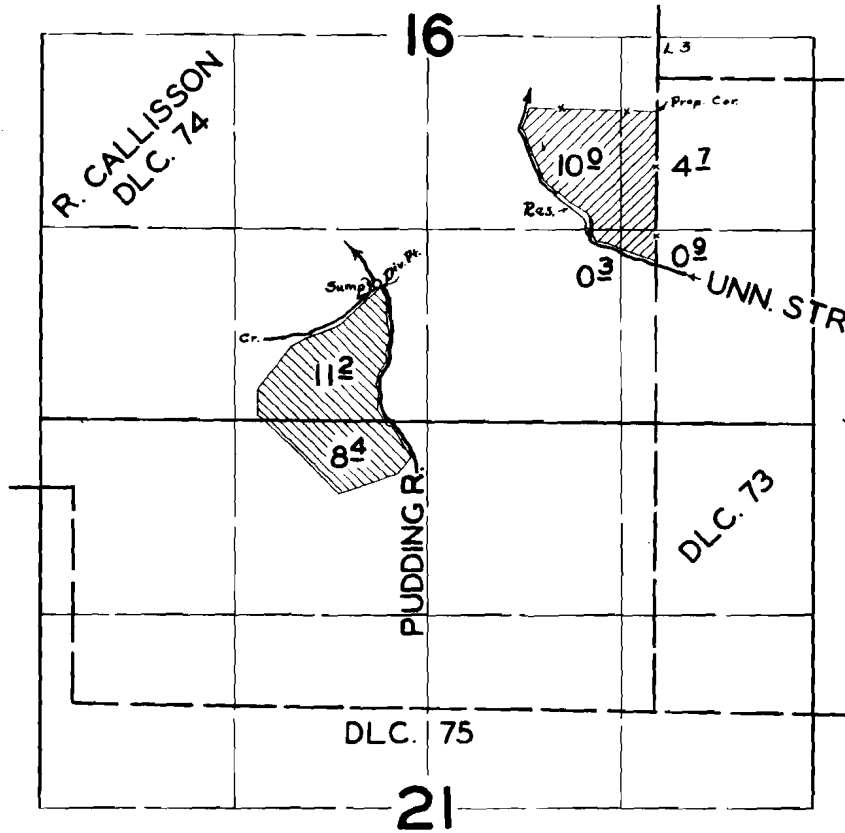

T. 18S. R. 2W. W.M.



FINAL PROOF SURVEY

UNDER

31120 24679 
31119 24678 
Application No. R-31118 Permit No. R-1979

IN NAME OF

ALBERT W. & EMMA D. DERY

Surveyed MAR. 25 1959, by M. BISH