


T. 19S. R. 3W. W.M.

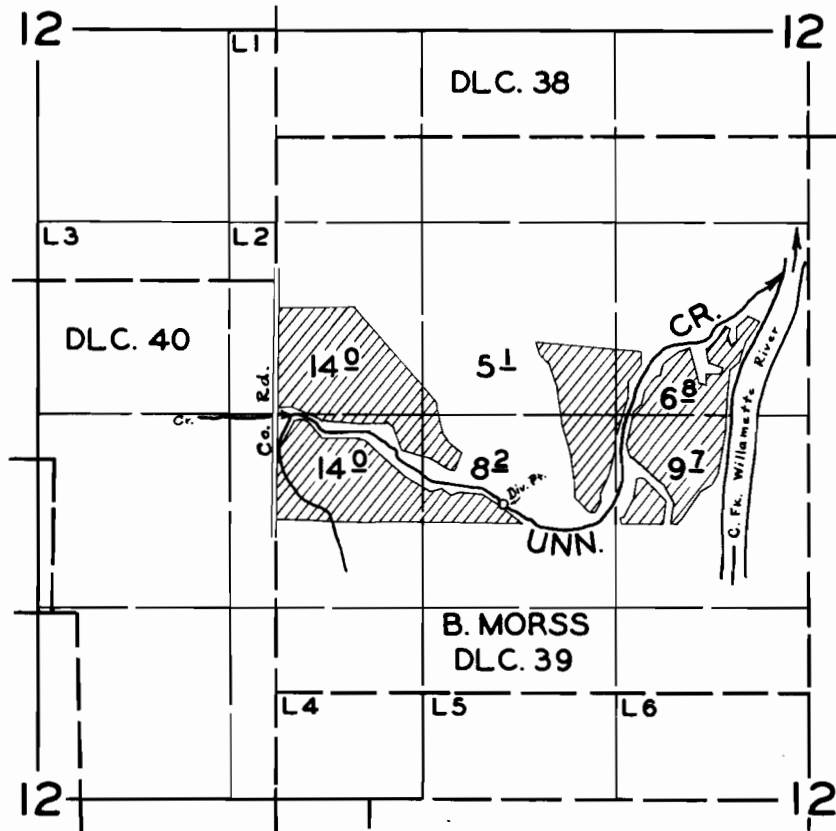

FINAL PROOF SURVEY
UNDER

Application No. 31330 Permit No. 24786
IN NAME OF

FOSTER G. HARROLD

Surveyed MAR. 31 1959, by M. BISH