


T. 18S. R. 3W. W.M.

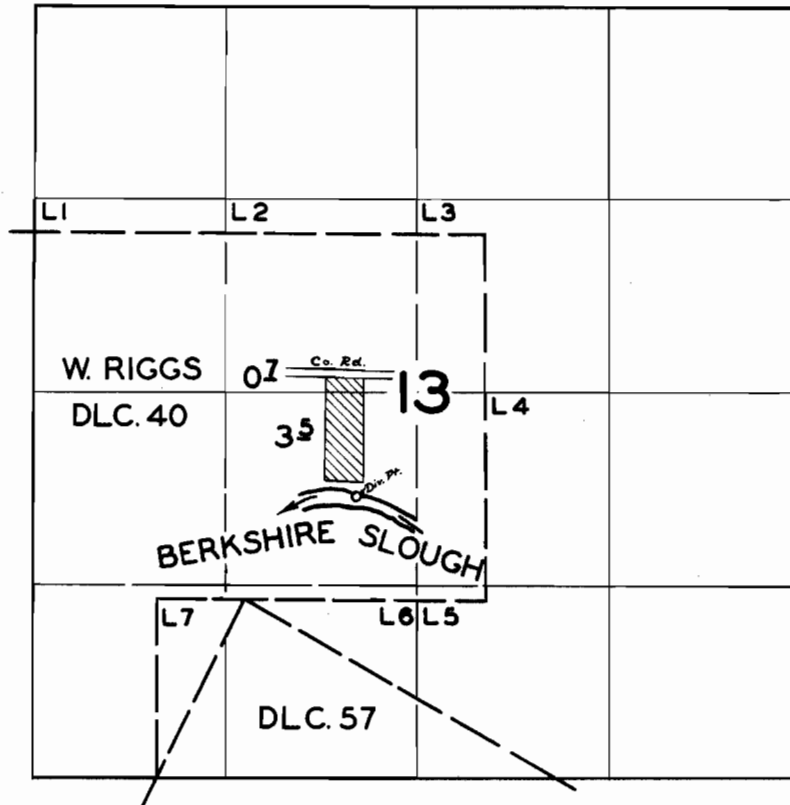

**FINAL PROOF SURVEY**  
UNDER

Application No. 29156 Permit No. 24948  
IN NAME OF

**DONALD BURCH**

Surveyed MAR. 24 1959, by M. BISH